

**City of Prince George
HISTORY SHEET**

004704851

SHEET NUMBER **N^o 4845** Roll Number **860**

Legal: LOT'S **23-24** BLOCK **3** D.L. **1429** PLAN **646**

Address: **1290 DOUGLAS STREET**

Sanitary Connection: # **3025** SIZE _____ MATERIAL _____ INV. _____ CONNECTED _____

Water Connection # **1313** SIZE **3/4"** MATERIAL **COPPER** METER _____ CONNECTED _____

Storm Connection: # _____ SIZE _____ MATERIAL _____ INV. _____ CONNECTED _____

Cash Receipt No's: WATER _____ SANITARY _____ STORM _____

CURB FROM PROPERTY LINE _____ PAVEMENT WIDTH _____

B.C. HYDRO _____ UNDERGROUND CONNECTION _____


B.C. TELEPHONE _____ UNDERGROUND CONNECTION _____

INLAND GAS _____

Information Sheets: _____

Comments: _____

SITE PLAN N.T.S.

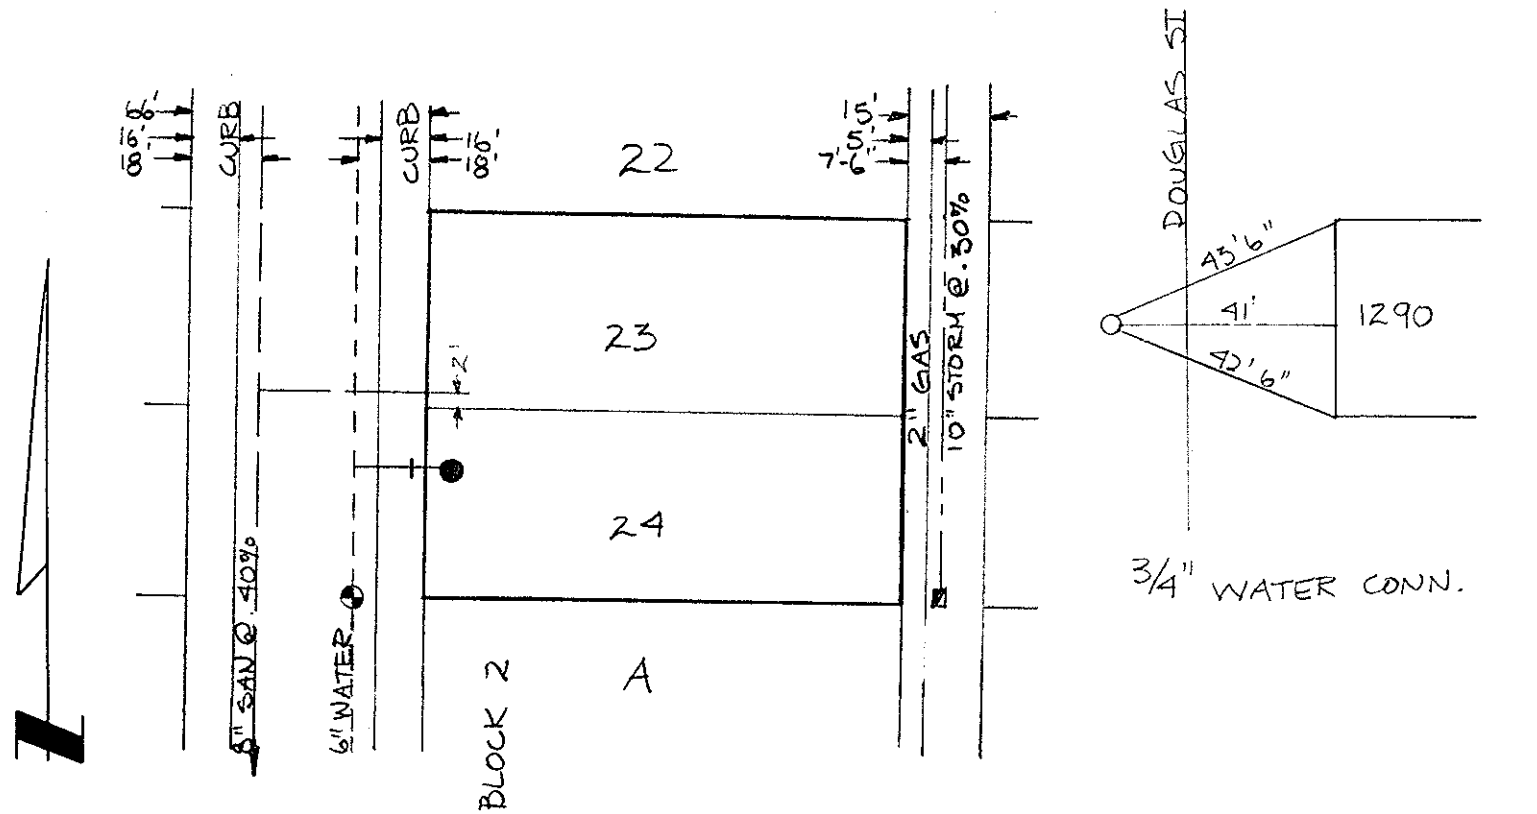

3/4" WATER CONN.