



City of Prince George
History Sheet

PID:	004704924
MU:	101238
WO:	61151/61152

Civic Address: 455 Victoria Street

Legal Description: Lot: AMD A District Lot: 343 Plan: 13541


Service Type	Diameter (mm)	Material	Invert Elev at main (m)	Invert Elev at property line (m)	Invert Elev at service end (m)	Distance into property (m)	Installation Date
Sanitary	150mm	PVC	-	-	-	-	January 1959
Water	150mm	PVC	-	-	-	-	October 2011
Storm	200mm	PVC	-	-	-	-	October 2011

Service Connection Location	Sanitary (m)	Storm (m)
150mm Sanitary service connected to San MH 2007	-	
200mm Storm service connected to Stm MH 3405		

Power	Size	Communications	Size	Cable	Size	Gas	Size
BC Hydro	-	Telus	-	Shaw	-	FortisBC	-
Overhead Service		Overhead Service		Overhead Service			

Installed by:	City of Prince George forces	Survey Date:	-
Comments:			

NOT TO SCALE The information contained herein is for internal use only.
Not to be relied on unless confirmed by site inspection and/or investigation.

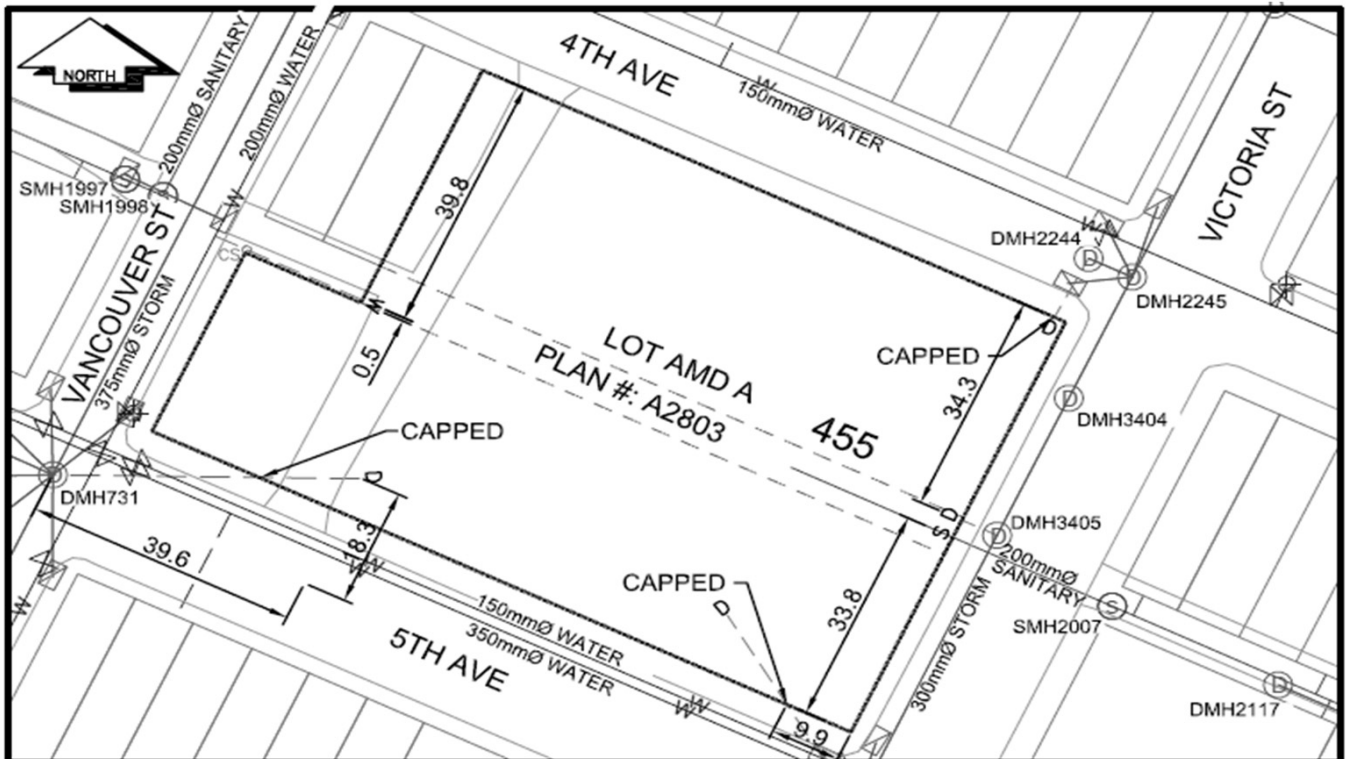

LEGEND:

- CS CURB STOP
- CO CLEAN OUT
- W WATER SERVICE
- S SANITARY SERVICE
- G GAS
- STORM SERVICE

NOT TO SCALE