

City of Prince George HISTORY SHEET

0047/47/7

SHEET NUMBER **No 4852** Roll Number **741**

Legal: LOT'S **19-20** BLOCK **4** D.L. **1429** PLAN **676**

Address: **1160 DOUGLAS STREET**

Sanitary Connection: # **1803** SIZE MATERIAL INV. CONNECTED

Water Connection # **3041** SIZE **3/4"** MATERIAL **COPPER** METER CONNECTED

Storm Connection: # SIZE MATERIAL INV. CONNECTED

Cash Receipt No's: WATER SANITARY STORM

CURB FROM PROPERTY LINE PAVEMENT WIDTH

B.C. HYDRO UNDERGROUND CONNECTION


B.C. TELEPHONE UNDERGROUND CONNECTION

INLAND GAS

Information Sheets:

Comments:

SITE PLAN N.T.S.

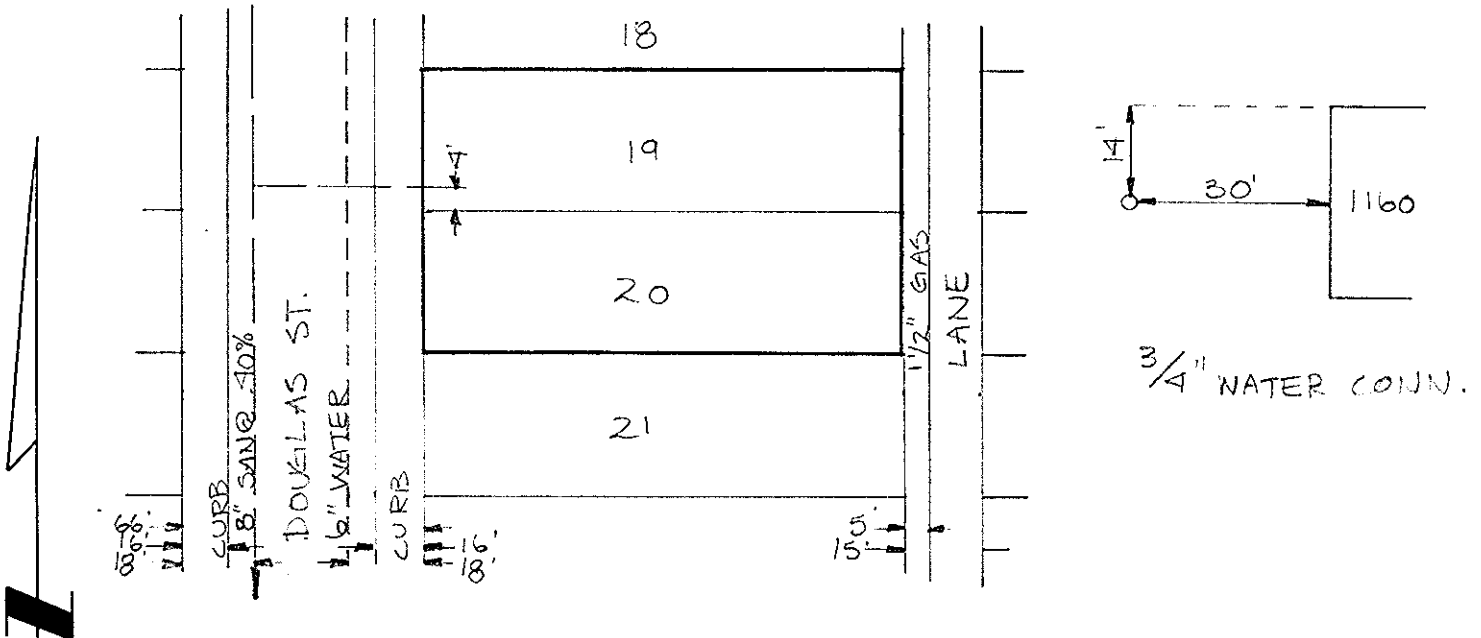

REPORT TO RECORDS

WATER SERVICE INFORMATION

Lot No. _____ Block _____ D.L. _____


Address 1160 Douglas Street

Size of Connection 1/2" 3/4" Other _____

Type of Connection Copper Iron

Thaw Wire Yes No

LOCATION SKETCH

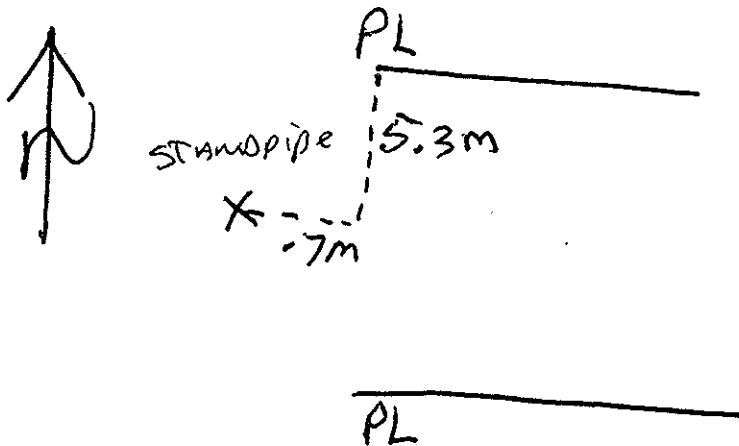

Field Location By JH Date Aug 9/02

Checked by: _____

Lot No. _____ Block _____ D.L. _____


Address 1160 Douglas Street

Size of Connection 100mm 150mm 200mm Other _____

Type of Connection Transite PVC Other _____

Type of Cap Transite Cast Iron

LOCATION SKETCH

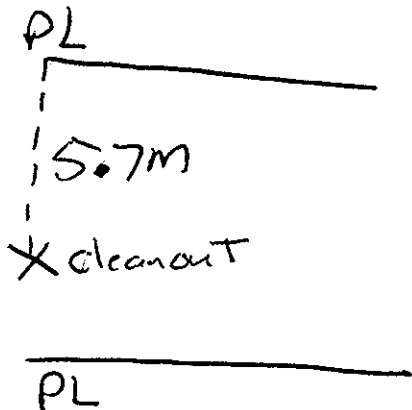

Field Location By JH Date Aug 9/02

Checked by Foreman - Sewer Division _____