



City of Prince George  
**History Sheet**

PID:	004727444
	004727487
SD/MU:	
WO:	

Civic Address: 980 Douglas St

Legal Description: Lot: 21, 22 Block: 6 District Lot: 1429 Plan: 646


Service Type	Diameter (mm)	Material	Invert Elev at main (m)	Invert Elev at property line (m)	Invert Depth at service end (m)	Distance into property (m)	Installation Date
Sanitary	100mm	AC	587.26	587.71	2.42	-	December 1959
Water	20mm	Copper	587.93	588.02	-	-	June 2015
Storm	N/A	N/A	-	-	-	-	

Service Connection Location				Sanitary (m)	Storm (m)
Distance from downstream San MH	1974	towards upstream San MH	3062	98.74	
Distance from downstream Stm MH	-	towards upstream Stm MH	-		

Power	Size	Communications	Size	Cable	Size	Gas	Size
BC Hydro	-	Telus	-	Shaw	-	FortisBC	-
Overhead Service		Overhead Service		Overhead Service			

Installed by:	Water service installed by City of Prince George forces	Survey Date:	-
Comments:			

**NOT TO SCALE** The information contained herein is for internal use only.  
Not to be relied on unless confirmed by site inspection and/or investigation.

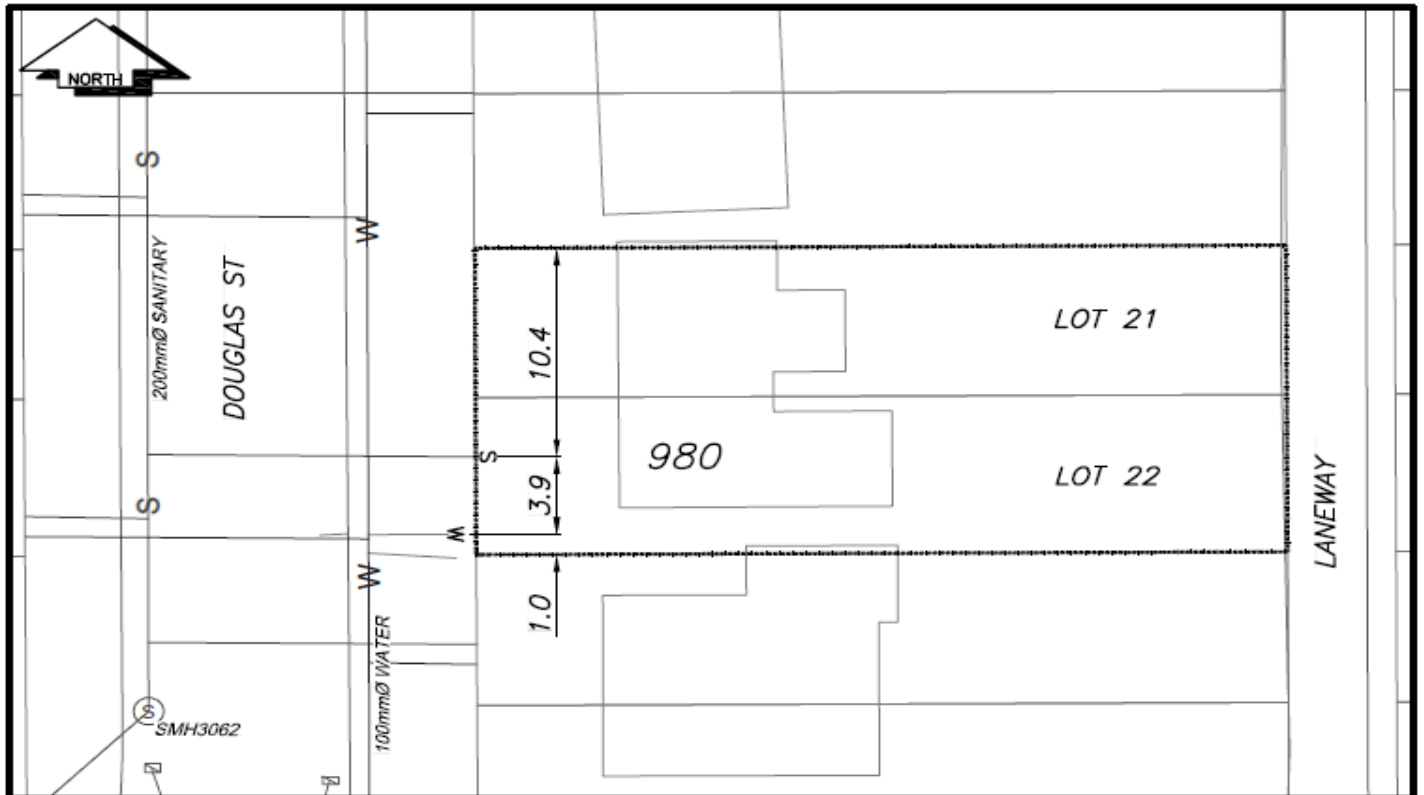

LEGEND:	
CS <sup>o</sup> CURB STOP	— W — WATER SERVICE
CO <sup>o</sup> CLEAN OUT	- - - S - - - SANITARY SERVICE
⊗ WATER VALVE	⊗ FIRE HYDRANT
	— G — GAS
	- - - - - ENCUMBRANCE
	— o — STORM SERVICE

**NOT TO SCALE**