



City of Prince George
History Sheet

PID:	004739680
MU:	101594
WO:	82449/82413

Civic Address: 530 Central St

Legal Description: Lot: PCL 1 District Lot: 937 Plan: 30928


Service Type	Diameter (mm)	Material	Invert Elev at main (m)	Invert Elev at property line (m)	Invert Elev at service end (m)	Distance into property (m)	Installation Date
Sanitary	150mm	PVC	596.24	596.40	-	-	April 2015
Water	150mm	PVC	-	-	-	-	April 2015
Storm	200mm	Vit	-	-	-	-	December 1965

Service Connection Location	Sanitary (m)	Storm (m)
150mm Sanitary service connecting connected to San MH5534	-	
150mm Storm service connected to Stm MH4161		

Power	Size	Communications	Size	Cable	Size	Gas	Size
BC Hydro	-	Telus	-	Shaw	-	FortisBC	-
Underground Service		Underground Service		Underground Service			

Installed by:	City of Prince George forces	Survey Date:	-
Comments:	Water and Sanitary services installed in same location as old abandoned water and sanitary services		

NOT TO SCALE The information contained herein is for internal use only.
Not to be relied on unless confirmed by site inspection and/or investigation.

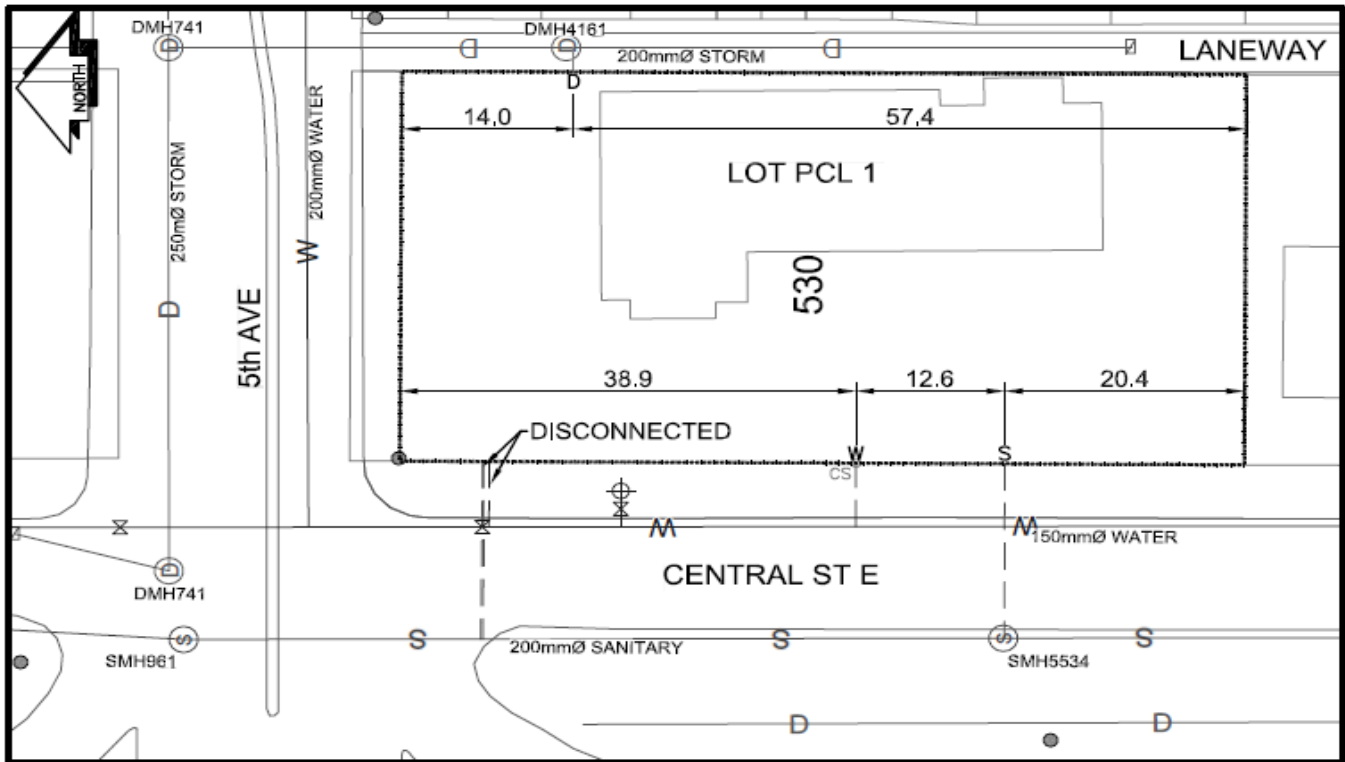

LEGEND:	
CURB STOP	WATER SERVICE
CLEAN OUT	SANITARY SERVICE
WATER VALVE	FIRE HYDRANT
	STORM SERVICE
	GAS
	ENCUMBRANCE

NOT TO SCALE