



City of Prince George
History Sheet

PID:	004743369
MU:	101908
WO:	94143/94149

Civic Address: 1694 7th Ave

Legal Description: Lot: B District Lot: 343 Plan: 21614


Service Type	Diameter (mm)	Material	Invert Elev at main (m)	Invert Elev at property line (m)	Invert Elev at service end (m)	Distance into property (m)	Installation Date
Sanitary	100mm	PVC	575.59	-	575.66	-	December 1955
Water	150mm	PVC	-	-	-	-	May 2018
Storm	100mm	PVC	575.32	-	-	-	May 2018

Service Connection Location				Sanitary (m)	Storm (m)
Distance from downstream San MH	3096	towards upstream San MH	2001	118.30	
Distance from downstream Stm MH	1316	towards upstream Stm MH	1317		68.97

Power	Size	Communications	Size	Cable	Size	Gas	Size
BC Hydro	-	Telus	-	Shaw	-	FortisBC	-
Underground Service		Underground Service		Underground Service			

Installed by:	City of Prince George forces	Survey Date:	-
Comments:			

NOT TO SCALE The information contained herein is for internal use only.
Not to be relied on unless confirmed by site inspection and/or investigation.

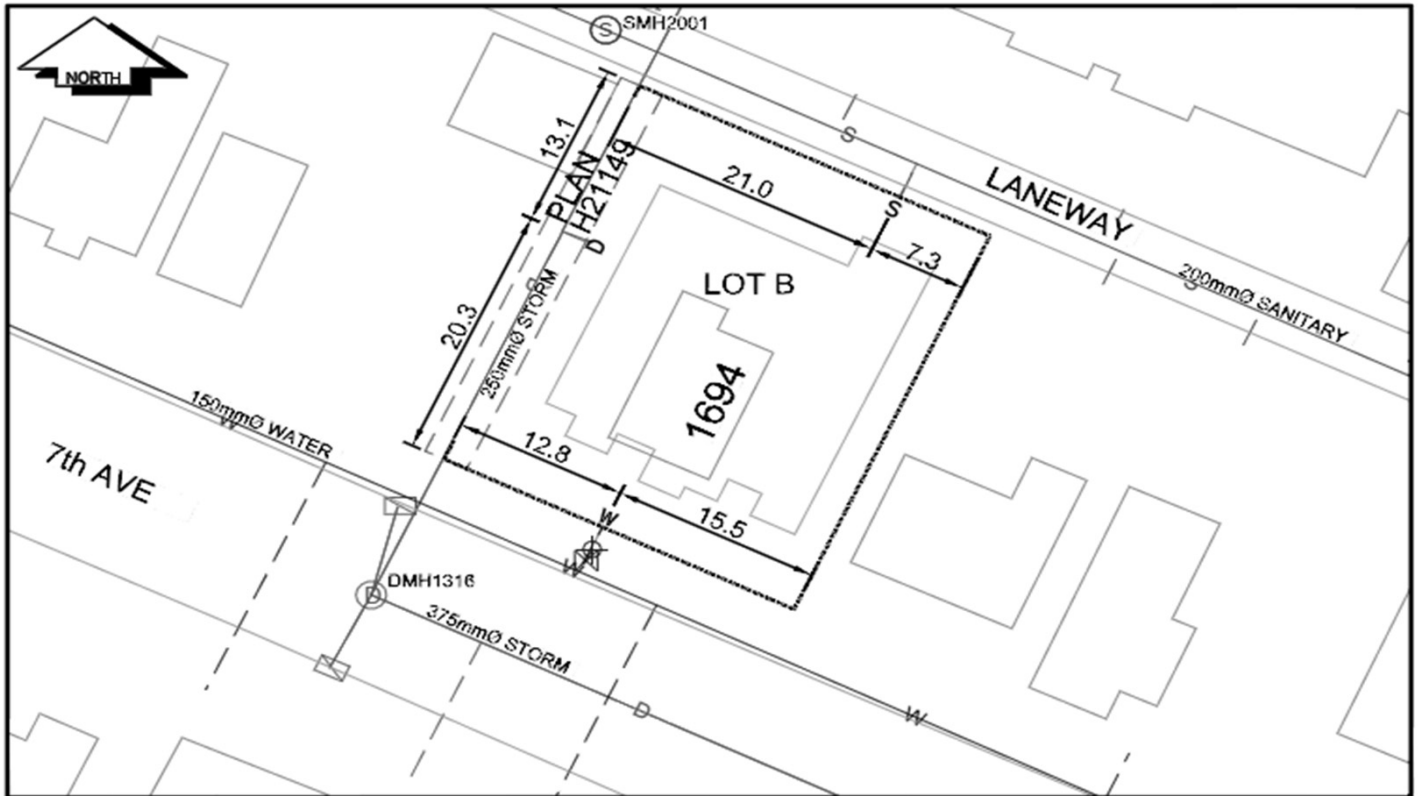

LEGEND:			
CS	CURB STOP	---	WATER SERVICE
CO	CLEAN OUT	---	SANITARY SERVICE
⊗	WATER VALVE	---	STORM SERVICE
		---	GAS
		⊕	FIRE HYDRANT
		---	ENCUMBRANCE

NOT TO SCALE