



City of Prince George
History Sheet

PID:	004744799
SD/MU:	
WO:	

Civic Address: 2994 Ingala Dr
3060 Oakridge Cres

Legal Description: Lot: 1 District Lot: 4046 Plan: 24336


Service Type	Diameter (mm)	Material	Invert Elev at main (m)	Invert Elev at property line (m)	Invert Elev at service end (m)	Distance into property (m)	Installation Date
Sanitary	100mm	PVC	-	729.10	-	-	January 1977
Water	20mm	Copper	-	-	-	-	January 1977
Storm	N/A	N/A	-	-	-	-	

Service Connection Location				Sanitary (m)	Storm (m)
Distance from downstream San MH	576	towards upstream San MH	592	55.50	
Distance from downstream Stm MH	-	towards upstream Stm MH	-		

Power	Size	Communications	Size	Cable	Size	Gas	Size
BC Hydro	-	Telus	-	Shaw	-	FortisBC	-
Overhead Service		Overhead Service		Overhead Service			

Installed by:		Survey Date:	-
Comments:	Water service confirmed April 01, 2017		

NOT TO SCALE The information contained herein is for internal use only.
Not to be relied on unless confirmed by site inspection and/or investigation.

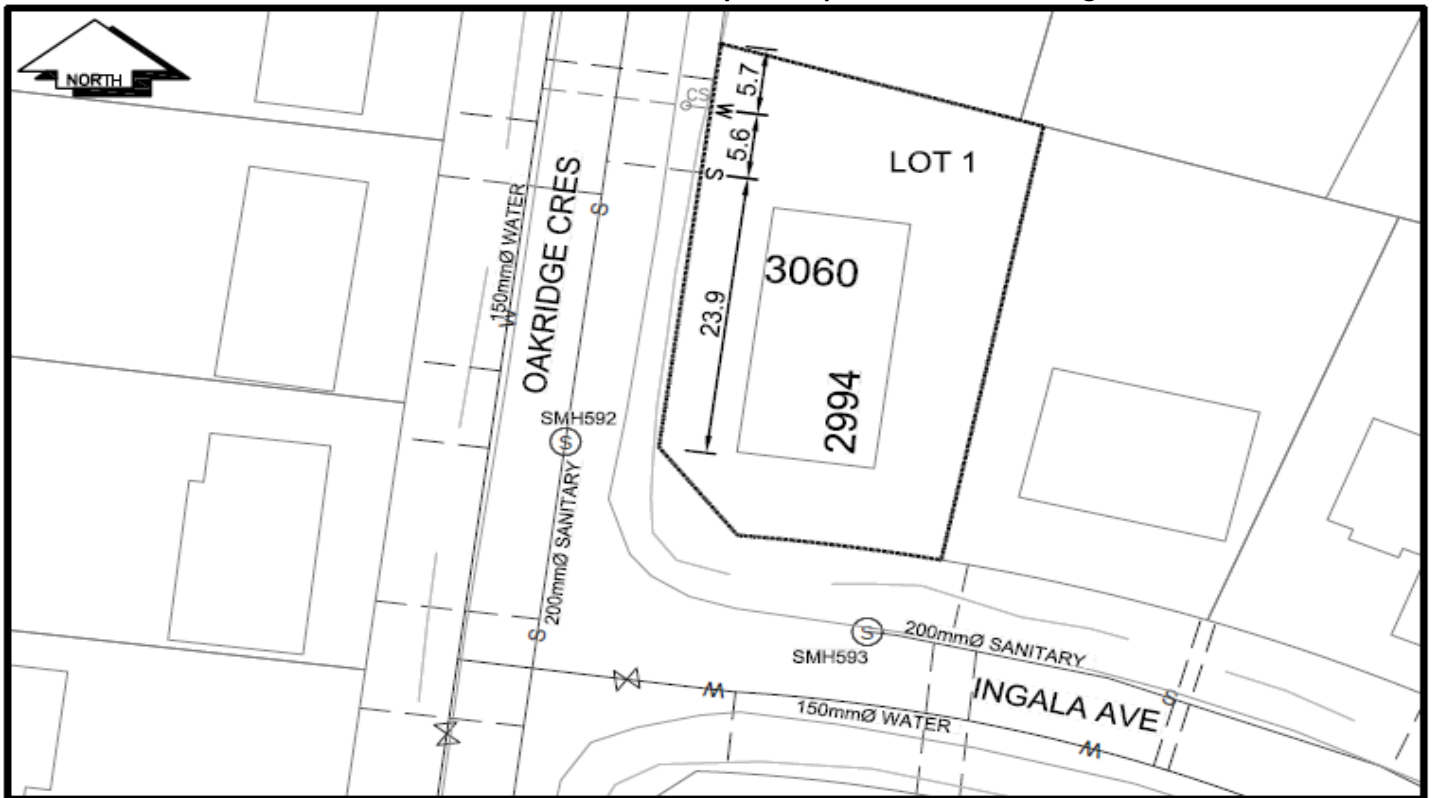

LEGEND:

CS ^o CURB STOP	--- WATER SERVICE	--- STORM SERVICE
CO ^o CLEAN OUT	--- SANITARY SERVICE	--- G GAS
X WATER VALVE	⊕ FIRE HYDRANT	--- ENCUMBRANCE

NOT TO SCALE