

City of Prince George HISTORY SHEET

	HISTORY SHEET			004745 809	
SHEET NUMBER Nº 4278			Roll Nu	mber 825	
Legal: Lor's 27-28	BLOCK 8	O.L	1429	PLAN 696	
Address: 866 ENER	T STREET				
Sanitary Connection: # 3440	SIZE	MATERIAL	INV.	CONNECTED	
Water Connection # 1353	SIZE 13 mm	MATERIAL	METER	CONNECTED	
Storm Connection:	SIZE	MATERIAL	INV.	CONNECTED	
Cash Receipt No's: WATER		SANITARY		FORM	
CURB FROM PROPERTY LINE	PAVEMENT WIDTH				
B.C. HYDRO	UNDERGROUND CONNECTION				
B.C. TELEPHONE	UNDERGROUND CONNECTION				
INLAND GAS					
Information Sheets:					
Comments:					

SITE PLAN N.T.S.

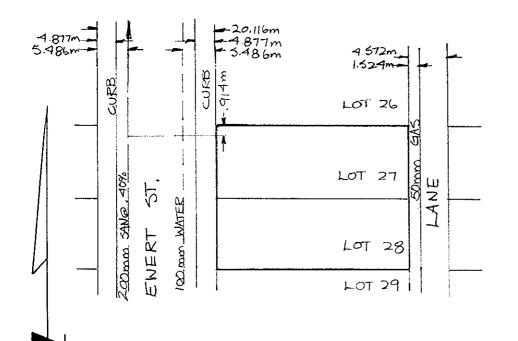

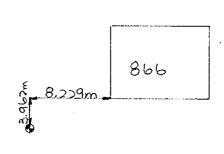

13mm WATER CONN.