



City of Prince George
History Sheet

| | |
|--------|-----------|
| PID: | 004747101 |
| | 004747097 |
| SD/MU: | |
| WO: | |

Civic Address: 1126 Ewert St

Legal Description: Lot: 15 16 Block: 11 District Lot: 1429 Plan: 646


| Service Type | Diameter (mm) | Material | Invert Elev at main (m) | Invert Elev at property line (m) | Invert Depth at service end (m) | Distance into property (m) | Installation Date |
|--------------|---------------|----------|-------------------------|----------------------------------|---------------------------------|----------------------------|-------------------|
| Sanitary | 100mm | AC | 587.56 | 588.69 | 1.97 | - | December 1956 |
| Water | 20mm | Copper | - | - | - | - | December 1956 |
| Storm | N/A | N/A | - | - | - | - | |

| Service Connection Location | | | | Sanitary (m) | Storm (m) |
|---------------------------------|------|-------------------------|------|--------------|-----------|
| Distance from downstream San MH | 2832 | towards upstream San MH | 3070 | 787.70 | |
| Distance from downstream Stm MH | - | towards upstream Stm MH | - | | |

| Power | Size | Communications | Size | Cable | Size | Gas | Size |
|------------------|------|------------------|------|------------------|------|----------|------|
| BC Hydro | - | Telus | - | Shaw | - | FortisBC | - |
| Overhead Service | | Overhead Service | | Overhead Service | | | |

| | | | |
|---------------|---------------------------|--------------|---|
| Installed by: | | Survey Date: | - |
| Comments: | Overhead power in laneway | | |
| | | | |
| | | | |

NOT TO SCALE The information contained herein is for internal use only.
Not to be relied on unless confirmed by site inspection and/or investigation.

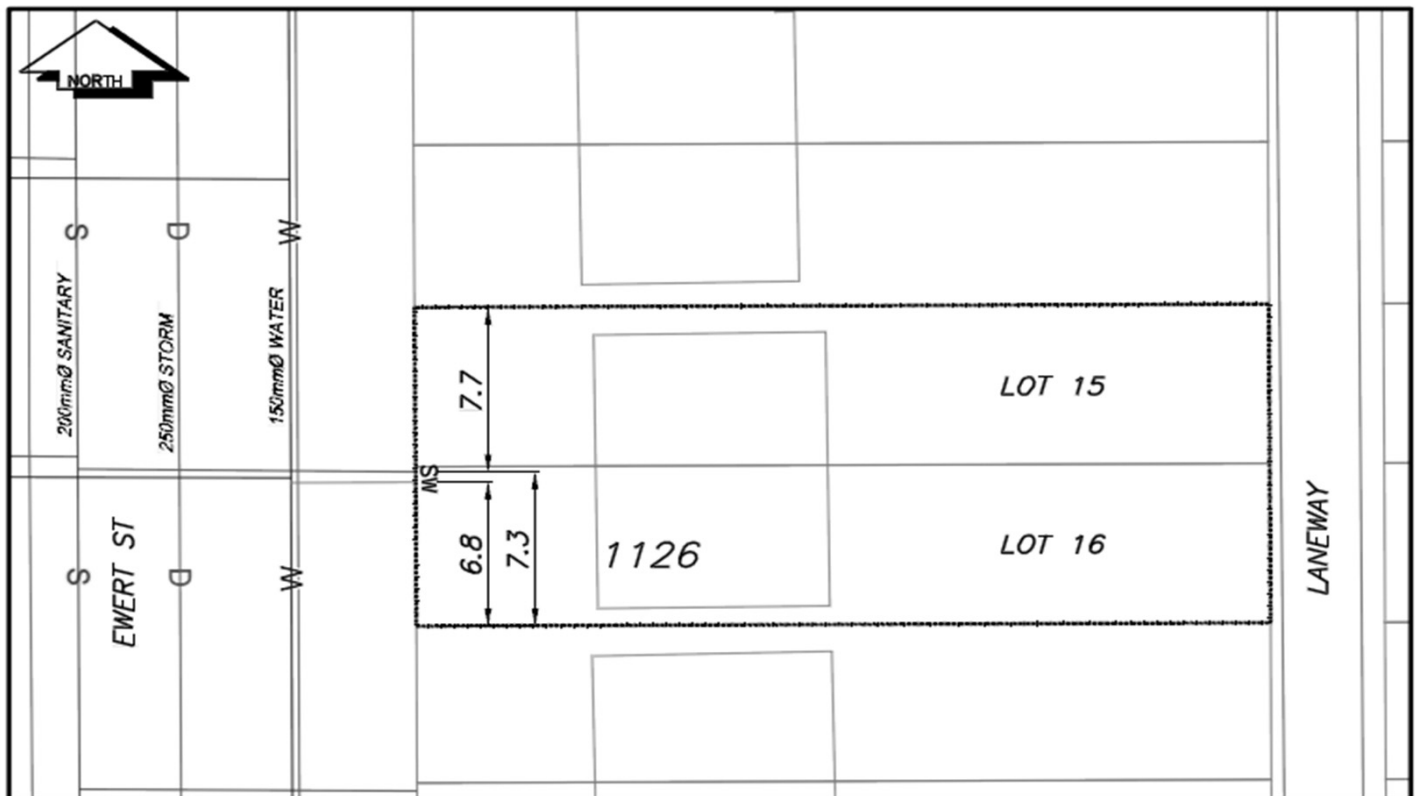

| LEGEND: | |
|-----------------|------------------|
| CS ^o | CURB STOP |
| CO ^o | CLEAN OUT |
| ⊗ | WATER VALVE |
| —W— | WATER SERVICE |
| - - - - S | SANITARY SERVICE |
| ⊗ | FIRE HYDRANT |
| —D— | STORM SERVICE |
| —G— | GAS |
| - - - - - | ENCUMBRANCE |

NOT TO SCALE