



City of Prince George  
**History Sheet**

PID:	004747101
	004747097
SD/MU:	
WO:	

Civic Address: 1126 Ewert St

Legal Description: Lot: 15 16 Block: 11 District Lot: 1429 Plan: 646


Service Type	Diameter (mm)	Material	Invert Elev at main (m)	Invert Elev at property line (m)	Invert Depth at service end (m)	Distance into property (m)	Installation Date
Sanitary	100mm	AC	587.56	588.69	1.97	-	December 1956
Water	20mm	Copper	-	-	-	-	December 1956
Storm	N/A	N/A	-	-	-	-	

Service Connection Location				Sanitary (m)	Storm (m)
Distance from downstream San MH	2832	towards upstream San MH	3070	787.70	
Distance from downstream Stm MH	-	towards upstream Stm MH	-		

Power	Size	Communications	Size	Cable	Size	Gas	Size
BC Hydro	-	Telus	-	Shaw	-	FortisBC	-
Overhead Service		Overhead Service		Overhead Service			

Installed by:		Survey Date:	-
Comments:	Overhead power in laneway		

**NOT TO SCALE** The information contained herein is for internal use only.  
Not to be relied on unless confirmed by site inspection and/or investigation.

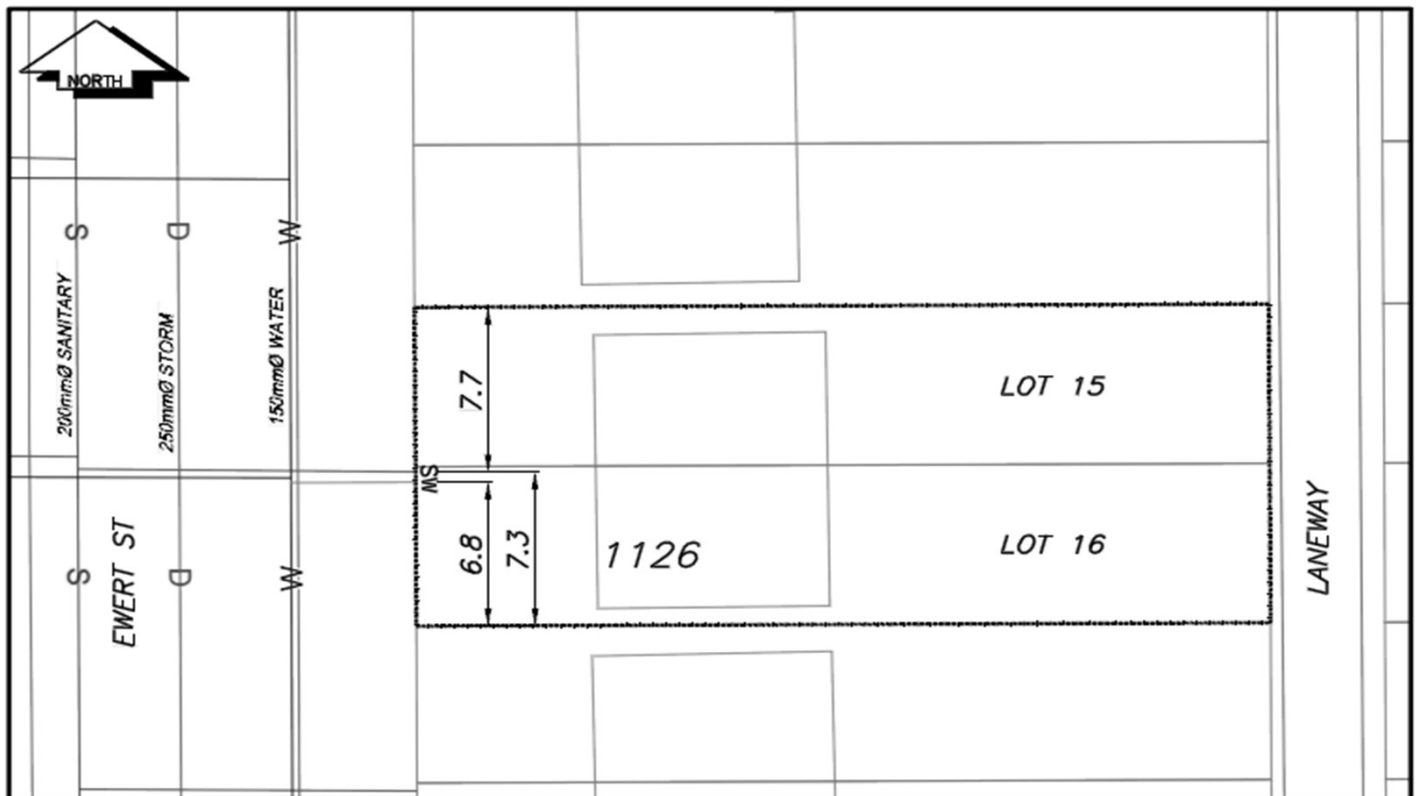

LEGEND:	
CS <sup>o</sup>	CURB STOP
CO <sup>o</sup>	CLEAN OUT
⊗	WATER VALVE
—W—	WATER SERVICE
- - - S - - -	SANITARY SERVICE
⊗	FIRE HYDRANT
—D—	STORM SERVICE
—G—	GAS
- - - - -	ENCUMBRANCE

**NOT TO SCALE**