

City of Prince George HISTORY SHEET

SHEET NUMBER

Roll Number 304748581

Legal: LOT'S 1 BLOCK D.L. 4047 PLAN 27889

Address: 4163 WEST AUSTIN ROAD

Sanitary Connection: # 12299 SIZE 100mm MATERIAL INV. 754.148 CONNECTED

Water Connection # SIZE 20mm MATERIAL METER CONNECTED

Storm Connection: # SIZE MATERIAL INV. CONNECTED

Cash Receipt No's: WATER SANITARY 2291 STORM

CURB FROM PROPERTY LINE PAVEMENT WIDTH

B.C. HYDRO OH UNDERGROUND CONNECTION

B.C. TELEPHONE OH UNDERGROUND CONNECTION



INLAND GAS AS SHOWN

Information Sheets: 5.78

Comments: 22' FROM EAST

SITE PLAN N.T.S.

AUSTIN RD. WEST

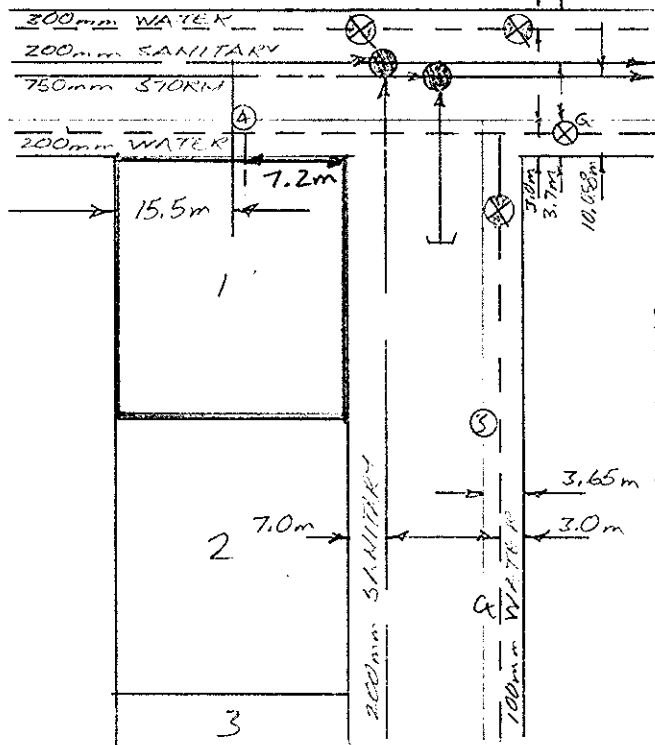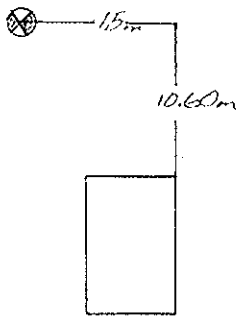

CROWN DR.