

**City of Prince George  
HISTORY SHEET**

00476/137

SHEET NUMBER **Nº 4356** Roll Number **146**

Legal: LOT'S **5-6** BLOCK **15** D.L. **1429** PLAN **646**

Address: **1461 EWERT ST**

Sanitary Connection: # **3698** SIZE MATERIAL INV. CONNECTED

Water Connection # **3446** SIZE **20mm** MATERIAL **COPPER** METER CONNECTED

Storm Connection: # SIZE MATERIAL INV. CONNECTED

Cash Receipt No's: WATER SANITARY STORM

CURB FROM PROPERTY LINE PAVEMENT WIDTH

B.C. HYDRO UNDERGROUND CONNECTION


B.C. TELEPHONE UNDERGROUND CONNECTION

INLAND GAS

Information Sheets:

Comments:

SITE PLAN N.T.S.

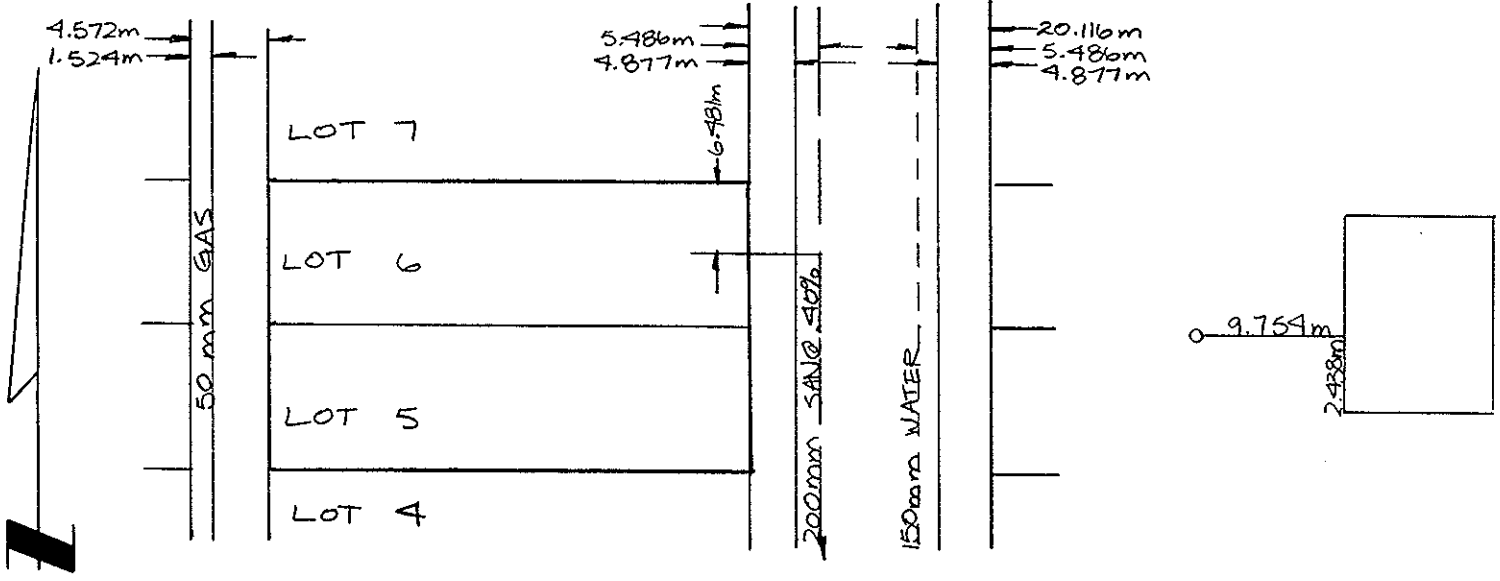

# REPORT TO RECORDS

## SEWER SERVICE INFORMATION

546 / 15 / 1429 / 646

Lot No. \_\_\_\_\_ Block \_\_\_\_\_ D.L. \_\_\_\_\_


Address 1461 EWEART.

Size of Connection  100mm  150mm  200mm  Other \_\_\_\_\_

Type of Connection  Transite  PVC  Other \_\_\_\_\_

Type of Cap  Transite  Cast Iron

### LOCATION SKETCH

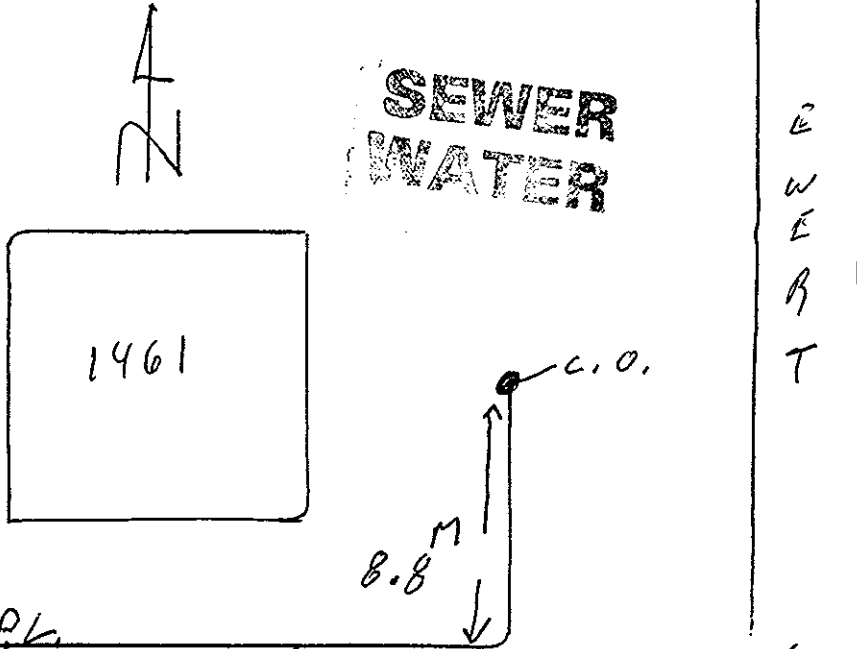

Field Location By Alan A. King Date DEC. 19/00

Checked by Foreman - Sewer Division \_\_\_\_\_