

**City of Prince George
HISTORY SHEET**

004/64480
FM

994007

SHEET NUMBER

Roll Number

Legal: LOT'S 211 BLOCK — D.L. 482 PLAN 20916

Address: 4418 URQUHART CRES.

Sanitary Connection: # 8697 SIZE 100mm MATERIAL A.C INV. — CONNECTED

Water Connection # 8697 SIZE 40mm
20mm MATERIAL COPPER METER — CONNECTED

Storm Connection: # — SIZE — MATERIAL — INV. — CONNECTED

Cash Receipt No's: WATER 23323 SANITARY — STORM —

CURB FROM PROPERTY LINE 4.877 PAVEMENT WIDTH 10.363 m

B.C. HYDRO U/G UNDERGROUND CONNECTION



B.C. TELEPHONE U/G UNDERGROUND CONNECTION

INLAND GAS AS SHOWN

Information Sheets:

Comments: WITH THIN WIRE

**THE INFORMATION CONTAINED HEREIN IS FOR INTERNAL USE ONLY.
NOT TO BE RELIED UPON UNLESS CONFIRMED BY SITE INSPECTION AND/OR INVESTIGATION**

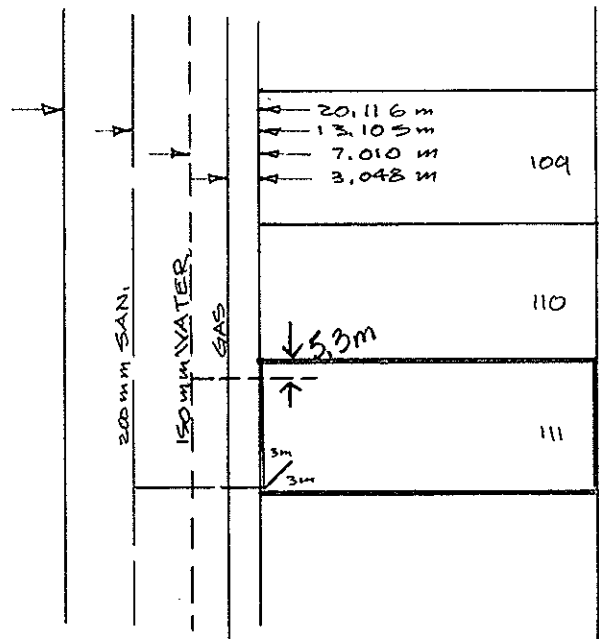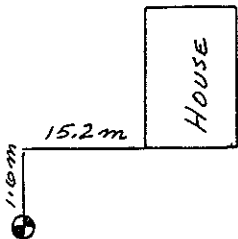

URQUHART
CRES.