

City of Prince George HISTORY SHEET

004721486

SHEET NUMBER _____ Roll Number 524

Legal: LOT'S 1-2-1 BLOCK 17 D.L. 1423 PLAN 646/10594

Address: 1285 EVERT ST.

Sanitary Connection: # 94 SIZE _____ MATERIAL _____ INV. _____ CONNECTED _____

Water Connection # 1450 SIZE 20 mm MATERIAL COP. METER _____ CONNECTED _____

Storm Connection: # _____ SIZE _____ MATERIAL _____ INV. _____ CONNECTED _____

Cash Receipt No's: WATER _____ SANITARY _____ STORM _____

CURB FROM PROPERTY LINE _____ PAVEMENT WIDTH _____

B.C. HYDRO _____ UNDERGROUND CONNECTION _____


B.C. TELEPHONE _____ UNDERGROUND CONNECTION _____

INLAND GAS _____

Information Sheets: The information contained herein is for

Comments: internal use only. Not to be relied upon unless confirmed by site inspection and/or investigation.

SITE PLAN N.T.S.

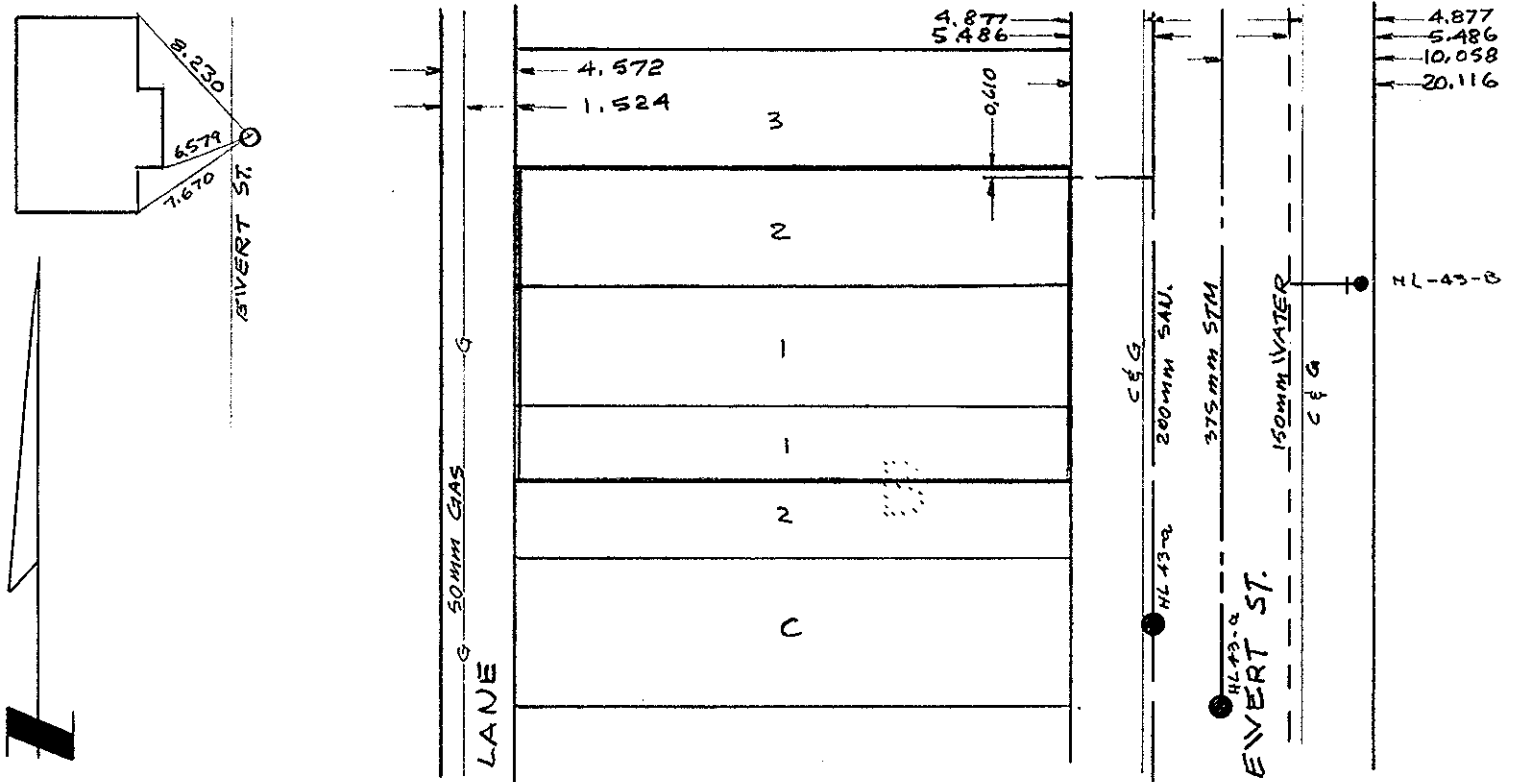

REPORT TO RECORDS

SEWER SERVICE INFORMATION

Lot No. _____ Block _____ D.L. _____


Address 1285 EWERT ST

Size of Connection 100mm 150mm 200mm Other _____

Type of Connection Transite PVC Other _____

Type of Cap Transite Cast Iron

LOCATION SKETCH

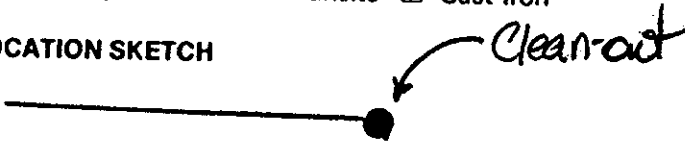

Descriptions:

Installed on the north-east property-line



Field Location By W Bond Date April 23, 2001

Checked by Foreman - Sewer Division _____