

**City of Prince George
HISTORY SHEET**

00-1223 492

SHEET NUMBER

PID #

501

Legal: LOTS 17-18 BLOCK 20 D.L. 1429 PLAN 646

Address: 944 FREEMAN ST.

Sanitary Connection: # ³⁴⁹¹ 9130 SIZE 100 mm MATERIAL A.C INV. 591.505 CONNECTED

Water Connection: # 1487 SIZE 20 mm MATERIAL C.U. METER CONNECTED

Storm Connection: # SIZE mm MATERIAL INV. CONNECTED

Cash Receipt No's: WATER SANITARY STORM

CURB FROM PROPERTY LINE 4.877 m PAVEMENT WIDTH 10.363 m

B.C. HYDRO O/H UNDERGROUND CONNECTION


B.C. TELEPHONE O/H UNDERGROUND CONNECTION

INLAND GAS 1.524 m FROM R IN LANE.

Information Sheets:

Comments:

**THE INFORMATION CONTAINED HEREIN IS FOR INTERNAL USE ONLY.
NOT TO BE RELIED UPON UNLESS CONFIRMED BY SITE INSPECTION AND/OR INVESTIGATION**

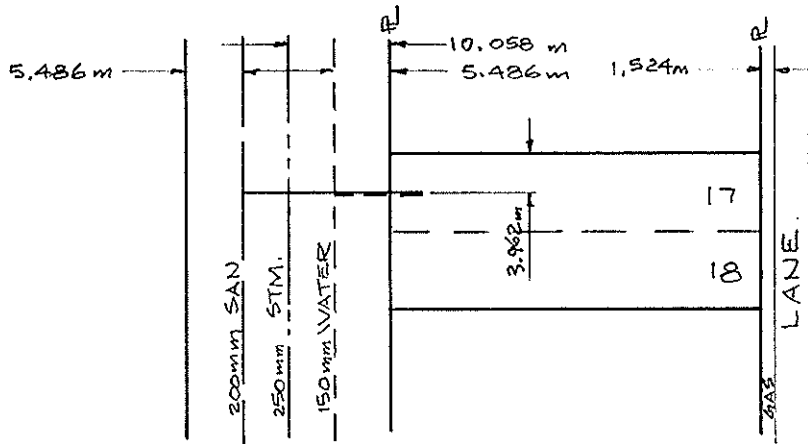

FREEMAN
ST.

