

City of Prince George HISTORY SHEET

SHEET NUMBER

Roll Number 004774799

Legal: LOT'S 166 BLOCK _____ D.L. 2507 PLAN 20 258

Address: 1050 FRANCOIS CRES.

Sanitary Connection: # 8044 SIZE 100 mm MATERIAL A.C. INV. _____ CONNECTED _____

Water Connection # 8044 SIZE 20 mm MATERIAL CU. METER _____ CONNECTED _____

Storm Connection: # _____ SIZE _____ MATERIAL _____ INV. _____ CONNECTED _____

Cash Receipt No's: WATER _____ SANITARY _____ STORM _____

CURB FROM PROPERTY LINE 4.877 m PAVEMENT WIDTH 10.363 m

B.C. HYDRO 0/G UNDERGROUND CONNECTION _____



B.C. TELEPHONE 0/G UNDERGROUND CONNECTION _____

INLAND GAS AS SHOWN

Information Sheets: _____

Comments: _____

**THE INFORMATION CONTAINED HEREIN IS FOR INTERNAL USE ONLY.
NOT TO BE RELIED UPON UNLESS CONFIRMED BY SITE INSPECTION AND/OR INVESTIGATION**

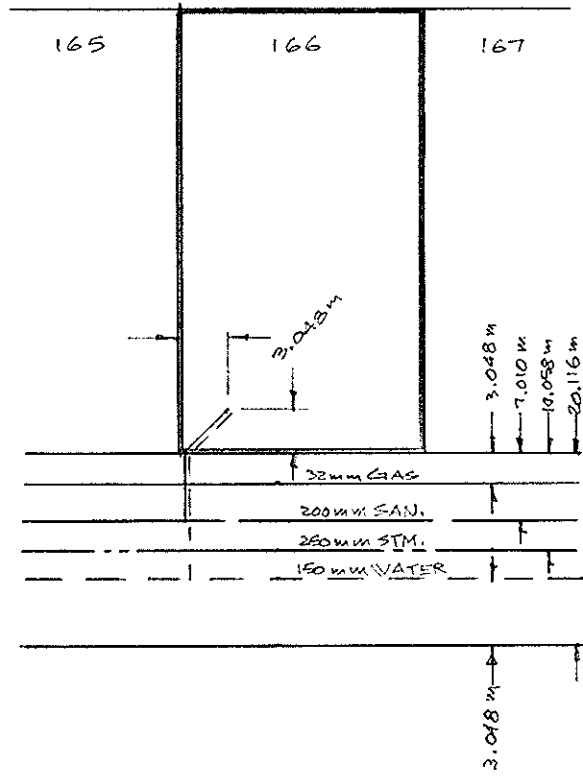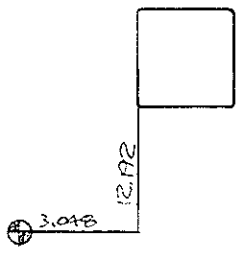

FRANCOIS
CRES.