

City of Prince George HISTORY SHEET

SHEET NUMBER **21** Roll Number 159-000

Legal: LOT'S **4 Ex A & B.** BLOCK _____ D.L. **742** PLAN **6743/2628**

Address: **18419-73 FIRST AVE**

Sanitary Connection: # **2762, ?** SIZE **4"** MATERIAL **AC.** INV. **1863.55** CONNECTED **YES**

Water Connection # **5445, 2219** SIZE **6", 1"** MATERIAL **A.C. - METER - -** CONNECTED **-**

Storm Connection: # **234** SIZE **8"** MATERIAL **AC.** INV. **1864.95** CONNECTED **YES**

Cash Receipt No's: WATER **104, 117** SANITARY **116** STORM **118**

CURB FROM PROPERTY LINE **10'** PAVEMENT WIDTH **54'**

B.C. HYDRO **O.H.** UNDERGROUND CONNECTION **-**


B.C. TELEPHONE **O.H.** UNDERGROUND CONNECTION **-**

INLAND GAS **ON 1ST AVE 6" ϕ MAIN. $\& 3/4", 1/2", 2" \phi$ MAINS IN ST.**

Information Sheets: **181**

Comments: The information contained herein is for internal use only. Not to be relied upon unless confirmed by site inspection and/or investigation.

SITE PLAN N.T.S.

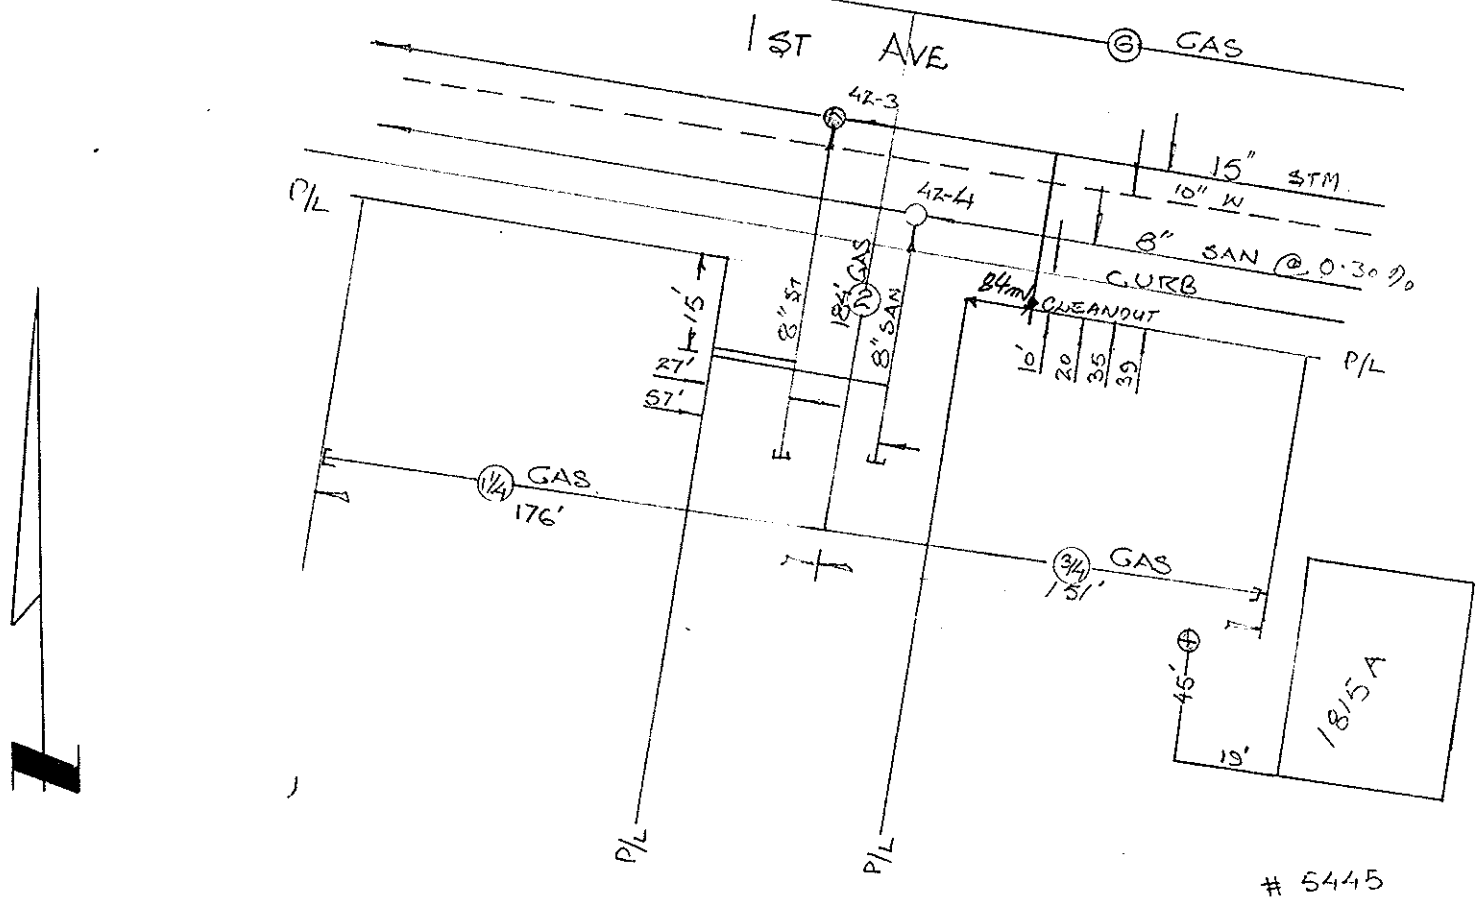

5445