

**City of Prince George  
HISTORY SHEET**

004783751

SHEET NUMBER

PID #

**Legal:**    LOTS    4                      BLOCK    H                      D.L.    777                      PLAN    22 854

**Address:**                      2165 TAMARACK ST.

**Sanitary Connection:** # 11046    SIZE 100 mm    MATERIAL A.C.    INV. 568.901    CONNECTED ✓

**Water Connection:** # 11046    SIZE 20 mm    MATERIAL CU.    METER                      CONNECTED ✓

**Storm Connection:** #                      SIZE                      mm    MATERIAL                      INV.                      CONNECTED

**Cash Receipt No's:**                      WATER                      SANITARY 977                      STORM

**CURB FROM PROPERTY LINE** 4.877 m                      **PAVEMENT WIDTH** 10.363 m

**B.C. HYDRO**    0/H                      **UNDERGROUND CONNECTION**



**B.C. TELEPHONE**    0/H                      **UNDERGROUND CONNECTION**

**INLAND GAS** 4.572 m FROM FL.

**Information Sheets:**

**Comments:** WITH THAW WIRE.

**THE INFORMATION CONTAINED HEREIN IS FOR INTERNAL USE ONLY.  
NOT TO BE RELIED UPON UNLESS CONFIRMED BY SITE INSPECTION AND/OR INVESTIGATION**

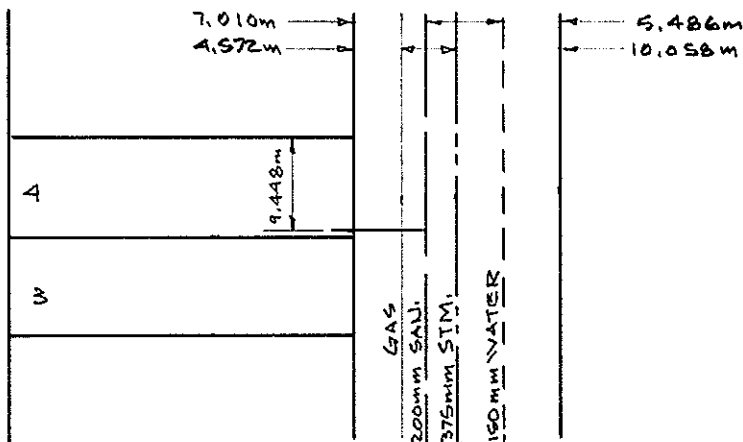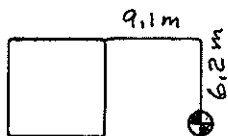

TAMARACK ST.

