

City of Prince George HISTORY SHEET

2054984120

SHEET NUMBER **N^o 1071** Roll Number **138**

Legal: LOT'S **25-26** BLOCK **36** D.L. **1429** PLAN **646**

Address: **866 IRWIN ST.**

Sanitary Connection: # **6028** SIZE MATERIAL INV. CONNECTED

Water Connection # **1584** SIZE MATERIAL METER CONNECTED

Storm Connection: # SIZE MATERIAL INV. CONNECTED

Cash Receipt No's: WATER SANITARY STORM

CURB FROM PROPERTY LINE PAVEMENT WIDTH

B.C. HYDRO UNDERGROUND CONNECTION




B.C. TELEPHONE UNDERGROUND CONNECTION

INLAND GAS

Information Sheets:

Comments:

SITE PLAN N.T.S.

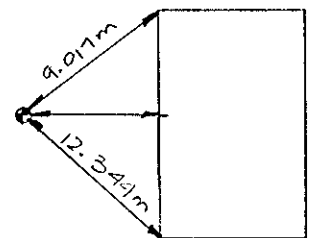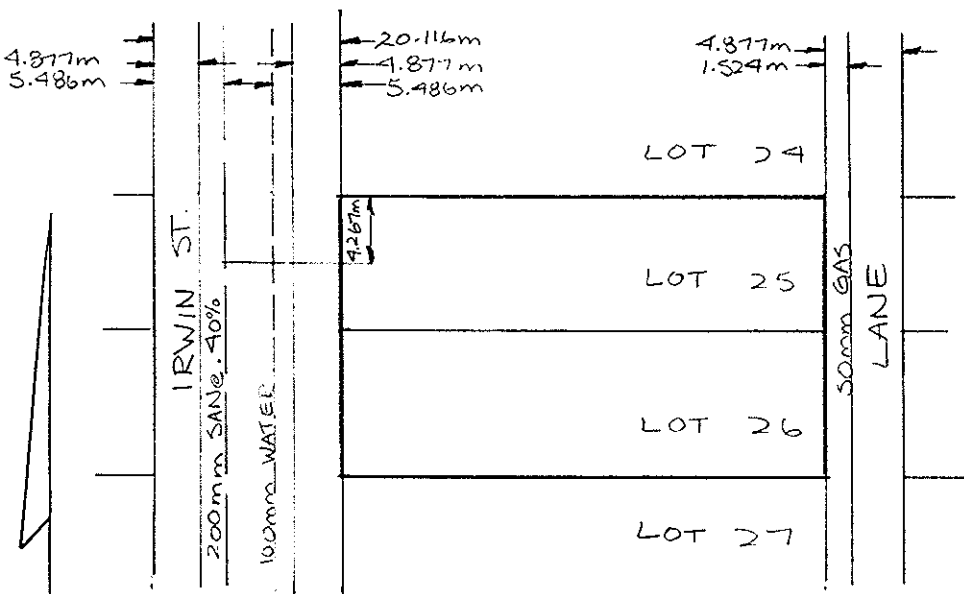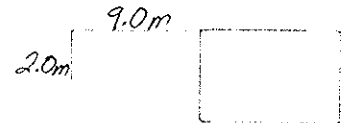

REPORT TO RECORDS

WATER SERVICE INFORMATION

Lot No. _____ Block _____ D.L. _____


Address 866. Irwin.

Size of Connection 1/2" 3/4" Other _____

Type of Connection Copper Iron

Thaw Wire Yes No

LOCATION SKETCH

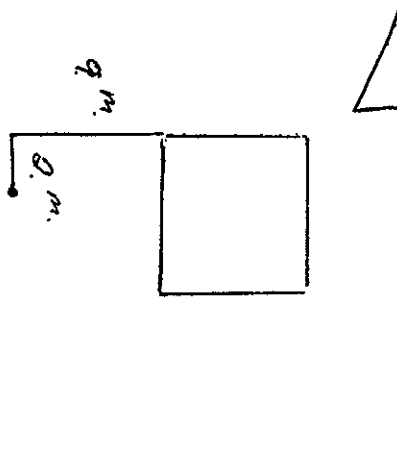

Field Location By G.C. Date 6/8/92.

Checked by: _____