

# City of Prince George HISTORY SHEET

2054984120

SHEET NUMBER **N<sup>o</sup> 1071** Roll Number **138**

Legal: LOT'S **25-26** BLOCK **36** D.L. **1429** PLAN **646**

Address: **866 IRWIN ST.**

Sanitary Connection: # **6028** SIZE MATERIAL INV. CONNECTED

Water Connection # **1584** SIZE MATERIAL METER CONNECTED

Storm Connection: # SIZE MATERIAL INV. CONNECTED

Cash Receipt No's: WATER SANITARY STORM

CURB FROM PROPERTY LINE PAVEMENT WIDTH

B.C. HYDRO UNDERGROUND CONNECTION




B.C. TELEPHONE UNDERGROUND CONNECTION

INLAND GAS

Information Sheets:

Comments:

SITE PLAN N.T.S.

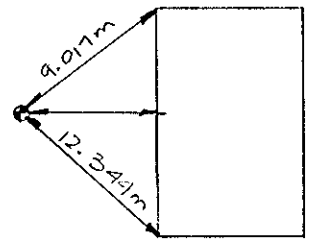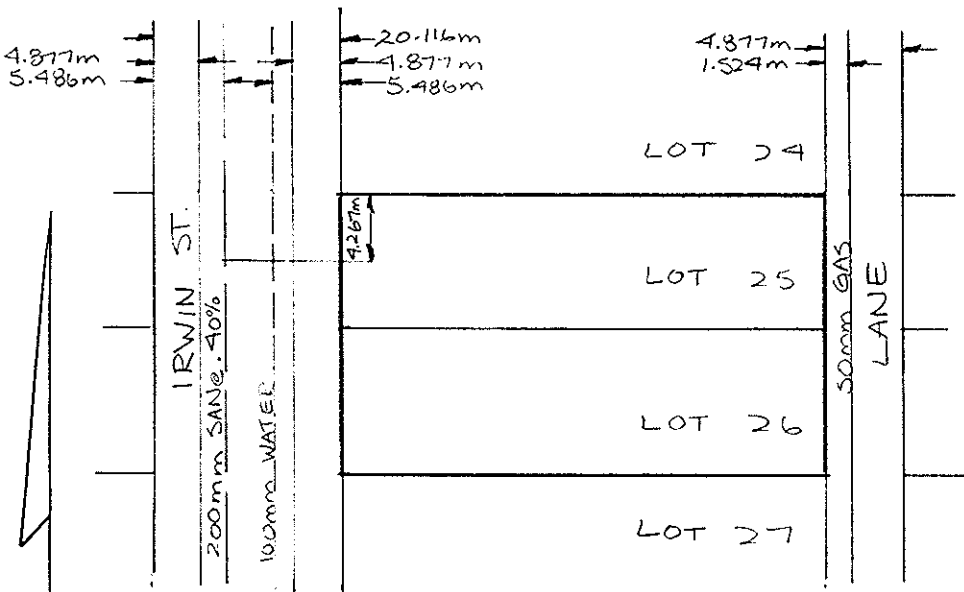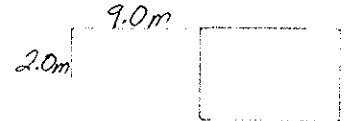

# REPORT TO RECORDS

## WATER SERVICE INFORMATION

Lot No. \_\_\_\_\_ Block \_\_\_\_\_ D.L. \_\_\_\_\_


Address 866. Irwin.

Size of Connection  1/2"  3/4"  Other \_\_\_\_\_

Type of Connection  Copper  Iron

Thaw Wire  Yes  No

### LOCATION SKETCH

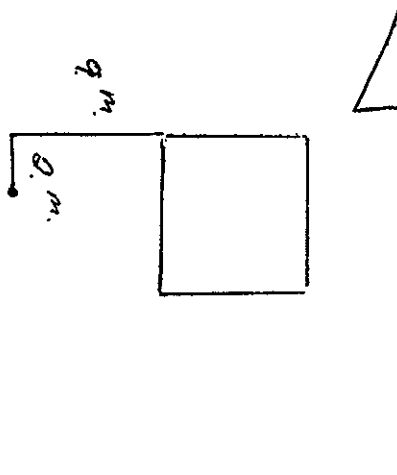

Field Location By G.C. Date 6/8/92.

Checked by: \_\_\_\_\_