

**City of Prince George
HISTORY SHEET**

J04785339

SHEET NUMBER

Roll Number

Legal: LOT'S 33 BLOCK 12 D.L. 932 PLAN 796

Address: 2271 NORWOOD STREET

Sanitary Connection: # 7195 SIZE 100mm MATERIAL A.C. INV. 566.436 CONNECTED

Water Connection # 7195 SIZE 20mm MATERIAL CU. METER CONNECTED

Storm Connection: # SIZE MATERIAL INV. CONNECTED

Cash Receipt No's: WATER SANITARY 436 STORM

CURB FROM PROPERTY LINE 2.558m PAVEMENT WIDTH 7.000m

B.C. HYDRO O/H UNDERGROUND CONNECTION



B.C. TELEPHONE O/H UNDERGROUND CONNECTION

INLAND GAS 3.657m FROM R.

Information Sheets:

Comments: WITH THAW WIRE.

SITE PLAN N.T.S.

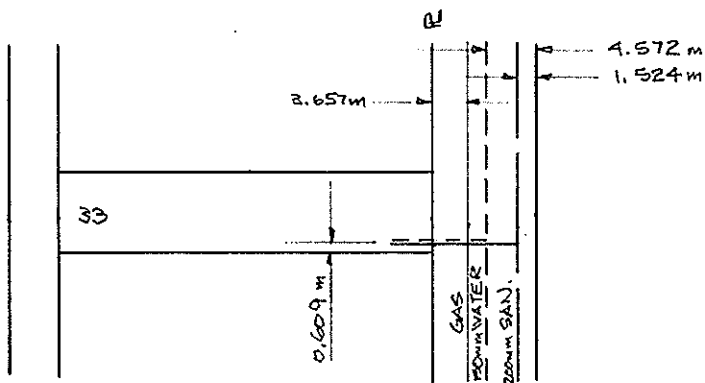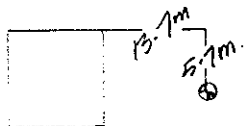

NORWOOD ST.

