

**City of Prince George
HISTORY SHEET**

004 785479

SHEET NUMBER

Roll Number ~~206-6491100~~

Legal: *PARCEL "A"* BLOCK D.L. 629 PLAN 19847
LOTS

Address: 2782 CESSNA RD

Sanitary Connection: # SIZE 150mm MATERIAL INV. CONNECTED

Water Connection # SIZE 20mm MATERIAL METER CONNECTED

Storm Connection: # SIZE MATERIAL INV. CONNECTED

Cash Receipt No's: WATER SANITARY STORM

CURB FROM PROPERTY LINE PAVEMENT WIDTH

B.C. HYDRO UNDERGROUND CONNECTION


B.C. TELEPHONE UNDERGROUND CONNECTION

INLAND GAS

THE INFORMATION CONTAINED HEREIN IS FOR INTERNAL
USE ONLY. NOT TO BE RELIED UPON UNLESS CONFIRMED
BY SITE INSPECTION AND/OR INVESTIGATION.

Information Sheets:

Comments: Parcel "A" combines Block 35+46 into one parcel - Aug 1977

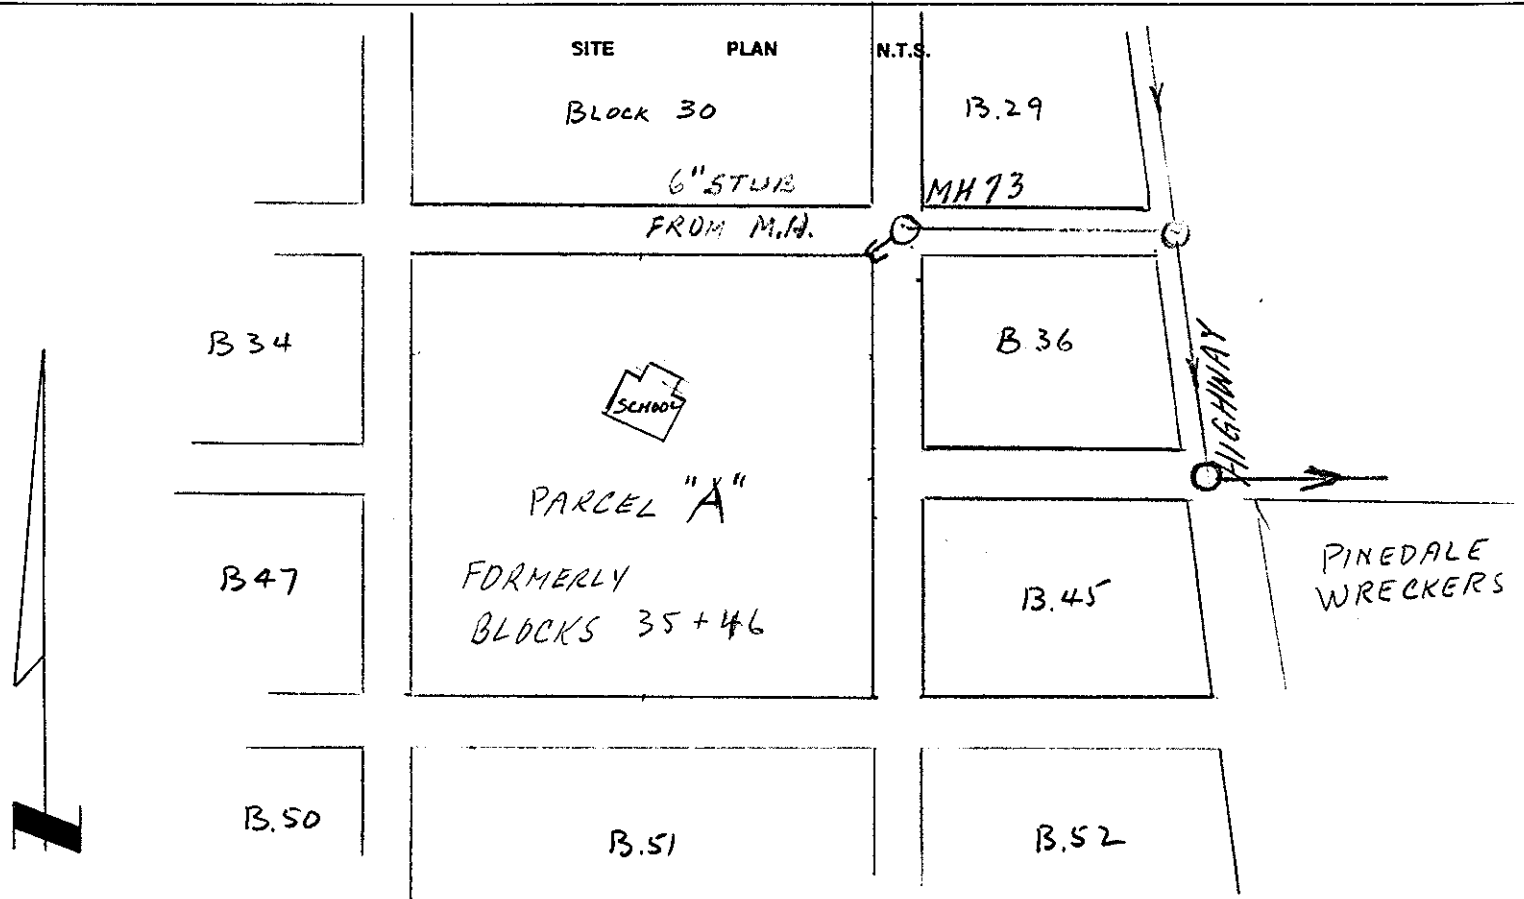

REPORT TO RECORDS

WATER SERVICE INFORMATION

Lot No. _____ Block _____ D.L. _____


Address 2782 CESSNA

Size of Connection 1/2" 3/4" Other PLASTIC

Type of Connection Copper Iron

Thaw Wire P Yes No

LOCATION SKETCH

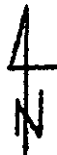


2782

CESSNA.

AUTO WRECKER. PL

(OLD SCHOOL)

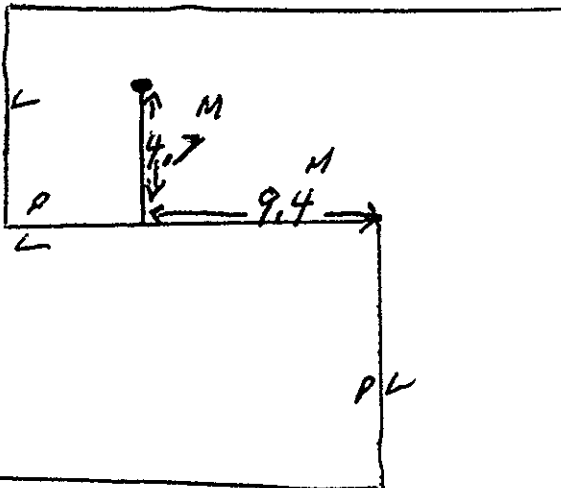

Field Location By A. Smith Date Oct. 20/99.

Checked by: _____