

# City of Prince George HISTORY SHEET

221 660 387  
304 820 134

SHEET NUMBER

Roll Number

Legal: LOT'S 24 - A      BLOCK 72      D.L. 937      PLAN 752

Address: 392 N. NICHOLSON ST.

Sanitary Connection: # 3236      SIZE 100mm      MATERIAL A.C.      INV. 602.073      CONNECTED ✓

Water Connection # 3287      SIZE 20mm      MATERIAL CU.      METER      CONNECTED ✓

Storm Connection: #      SIZE      MATERIAL      INV.      CONNECTED

Cash Receipt No's:      WATER      SANITARY      STORM

CURB FROM PROPERTY LINE 4.877m      PAVEMENT WIDTH 10.363m

B.C. HYDRO O/H      UNDERGROUND CONNECTION

B.C. TELEPHONE O/H      UNDERGROUND CONNECTION


INLAND GAS 1.524m FROM R IN LANE.

Information Sheets:

Comments: WITH THAW WIRE.



SITE      PLAN      N.T.S.

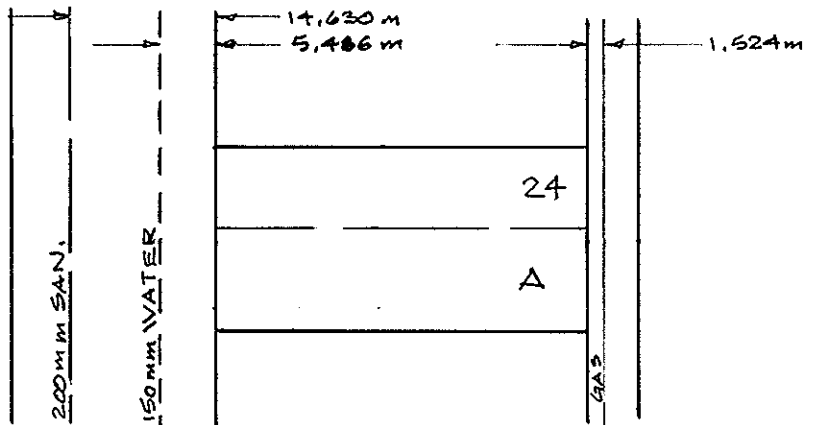

N. NICHOLSON ST.

