

**City of Prince George  
HISTORY SHEET**

201 660 301  
304 220 134

SHEET NUMBER

Roll Number

Legal: LOT'S 24 - A BLOCK 72 D.L. 937 PLAN 752

Address: 392 N. NICHOLSON ST.

Sanitary Connection: # 3236 SIZE 100mm MATERIAL A.C. INV. 602.073 CONNECTED

Water Connection # 3287 SIZE 20mm MATERIAL CU. METER \_\_\_\_\_ CONNECTED

Storm Connection: # \_\_\_\_\_ SIZE \_\_\_\_\_ MATERIAL \_\_\_\_\_ INV. \_\_\_\_\_ CONNECTED \_\_\_\_\_

Cash Receipt No's: WATER \_\_\_\_\_ SANITARY \_\_\_\_\_ STORM \_\_\_\_\_

CURB FROM PROPERTY LINE 4.877m PAVEMENT WIDTH 10.363m

B.C. HYDRO O/H UNDERGROUND CONNECTION \_\_\_\_\_

B.C. TELEPHONE O/H UNDERGROUND CONNECTION \_\_\_\_\_


INLAND GAS 1.524m FROM R IN LANE.

Information Sheets: \_\_\_\_\_

Comments: WITH THAW WIRE.



SITE PLAN N.T.S.

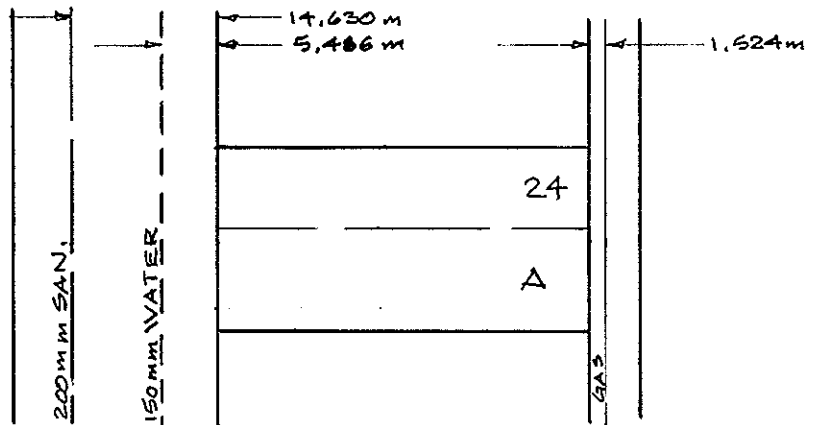

N. NICHOLSON ST.

