

# City of Prince George HISTORY SHEET

2

SHEET NUMBER **No 3292** Roll Number **00493147!**

Legal: LOT'S **106** BLOCK D.L. **2507** PLAN **15185**

Address: **1458 NATION CRES.**

Sanitary Connection: # **5650** SIZE MATERIAL INV. CONNECTED

Water Connection # **5650** SIZE **20<sup>φ</sup> mm** MATERIAL **Cu.** METER CONNECTED

Storm Connection: # SIZE MATERIAL INV. CONNECTED

Cash Receipt No's: WATER SANITARY STORM

CURB FROM PROPERTY LINE PAVEMENT WIDTH

B.C. HYDRO UNDERGROUND CONNECTION


B.C. TELEPHONE UNDERGROUND CONNECTION

INLAND GAS

Information Sheets:

Comments: **THAW WIRE** THE INFORMATION CONTAINED HEREIN IS FOR INTERNAL USE ONLY. NOT TO BE RELIED UPON UNLESS CONFIRMED BY SITE INSPECTION AND/OR INVESTIGATION.

SITE PLAN N.T.S.

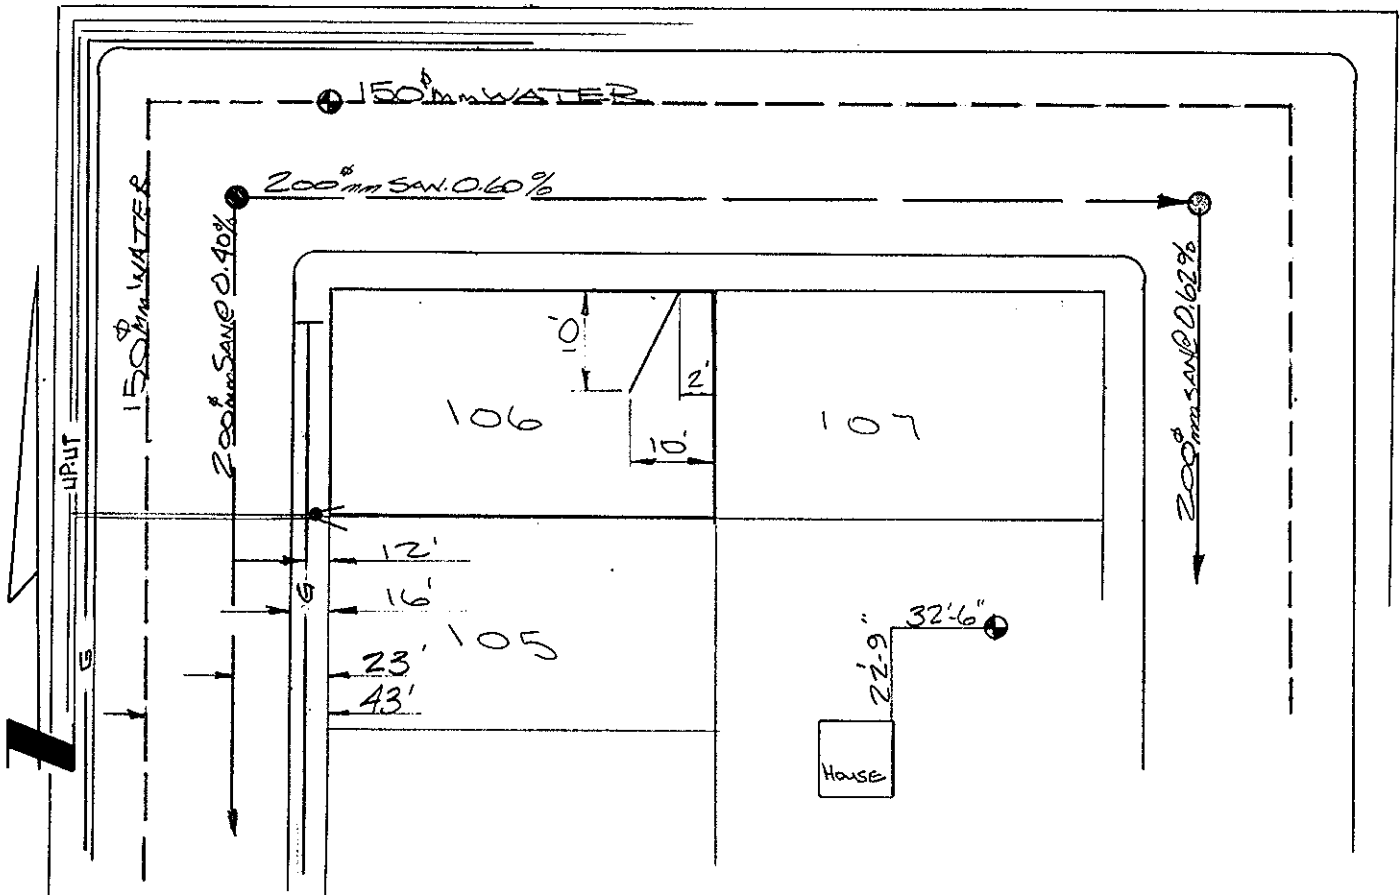

NATION CRES.