

City of Prince George

HISTORY SHEET

SHEET NUMBER

PID #

Legal: LOTS BLOCK D.L. 1427 PLAN PG512

Address: 4051 MCRAE AVE ; 199 N OSPIKA BLVD

Sanitary Connection: # SIZE mm MATERIAL INV. CONNECTED

Water Connection: # SIZE mm MATERIAL METER CONNECTED

Storm Connection: # SIZE mm MATERIAL INV. CONNECTED

Cash Receipt No's: WATER SANITARY STORM

CURB FROM PROPERTY LINE PAVEMENT WIDTH

B.C. HYDRO UNDERGROUND CONNECTION



B.C. TELEPHONE UNDERGROUND CONNECTION

INLAND GAS

Information Sheets:

Comments:

**THE INFORMATION CONTAINED HEREIN IS FOR INTERNAL USE ONLY.
NOT TO BE RELIED UPON UNLESS CONFIRMED BY SITE INSPECTION AND/OR INVESTIGATION**

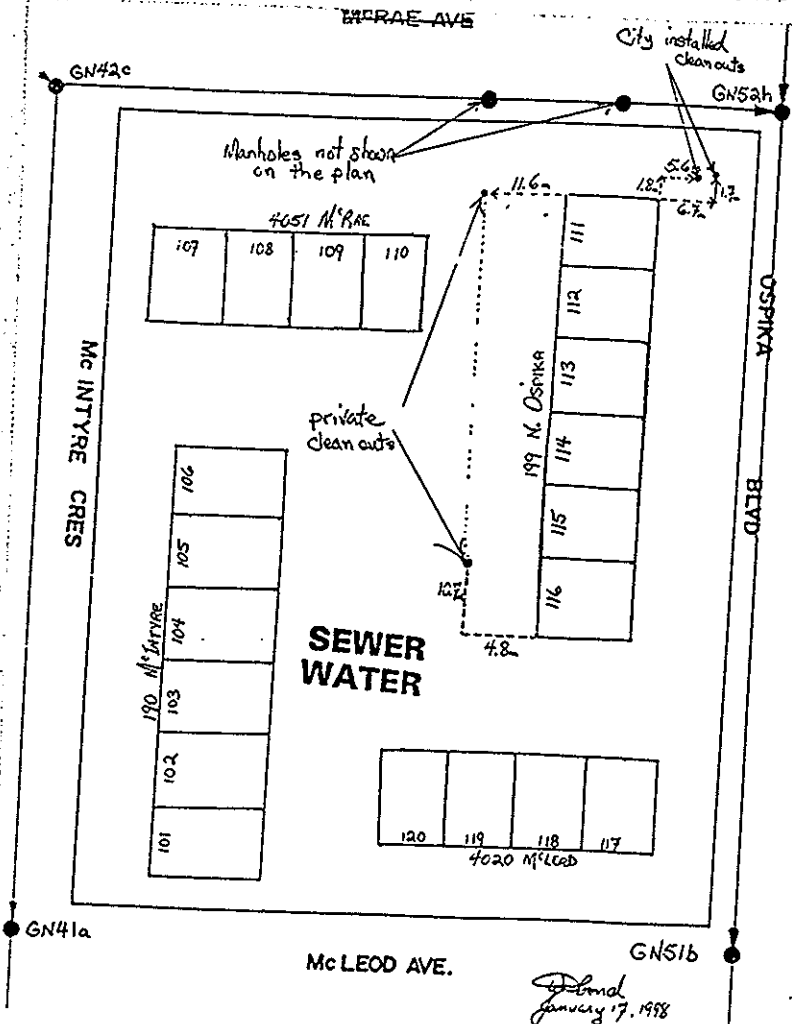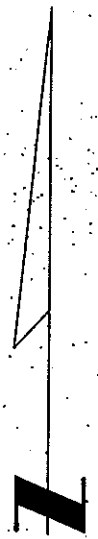

REPORT TO RECORDS

WATER SERVICE INFORMATION

009 60
999 605
005 001 757

Lot No. _____ Block _____ D.L. _____


Address 4051 M CRAE.

Size of Connection 1/2" 3/4" Other 2"

Type of Connection Copper Iron

Thaw Wire Yes No

LOCATION SKETCH

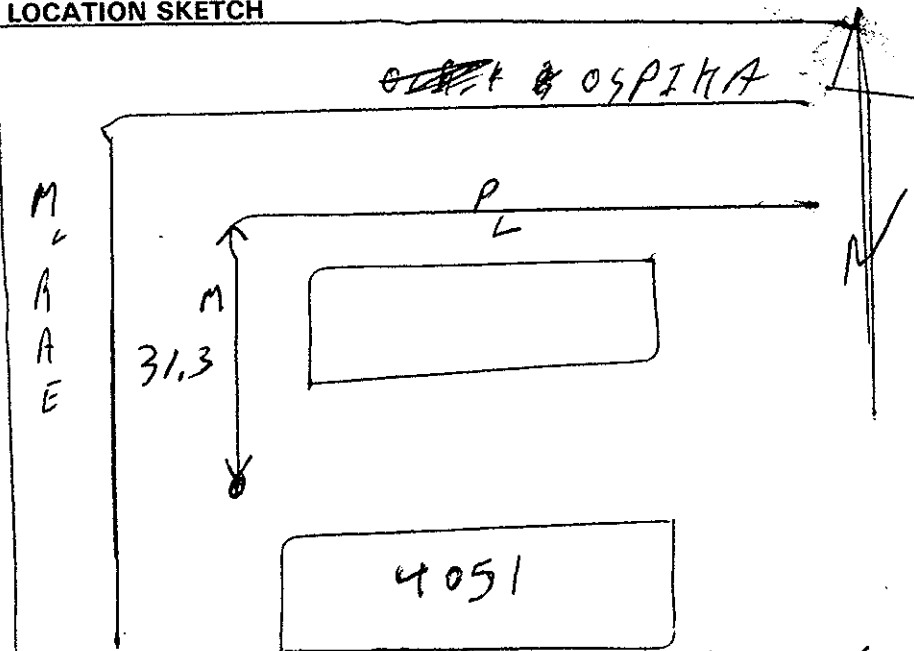

Field Location By Alexis A. Cox Date NOV. 26 / 02

Checked by: _____