



City of Prince George
History Sheet

PID:	004876687
SD/MU:	
WO:	

Civic Address: 1975 Garden Dr

Legal Description: Lot: 6 Block: K District Lot: 936 Plan: 10005


Service Type	Diameter (mm)	Material	Invert Elev at main (m)	Invert Elev at property line (m)	Invert Depth at service end (m)	Distance into property (m)	Installation Date
Sanitary	100mm	PVC	-	586.40	-	-	January 1964
Water	20mm	Copper	-	-	-	-	
Storm	N/A	N/A	-	-	-	-	

Service Connection Location				Sanitary (m)	Storm (m)
Distance from downstream San MH	3251	towards upstream San MH	3256	70.96	
Distance from downstream Stm MH	-	towards upstream Stm MH	-		

Power	Size	Communications	Size	Cable	Size	Gas	Size
BC Hydro	-	Telus	-	Shaw	-	FortisBC	-
Underground Service		Underground Service		Underground Service			

Installed by:	Survey Date:	-
Comments: Water service confirmed April 28, 2017		
Water and Sanitary services at SE corner of property		

NOT TO SCALE The information contained herein is for internal use only.
Not to be relied on unless confirmed by site inspection and/or investigation.

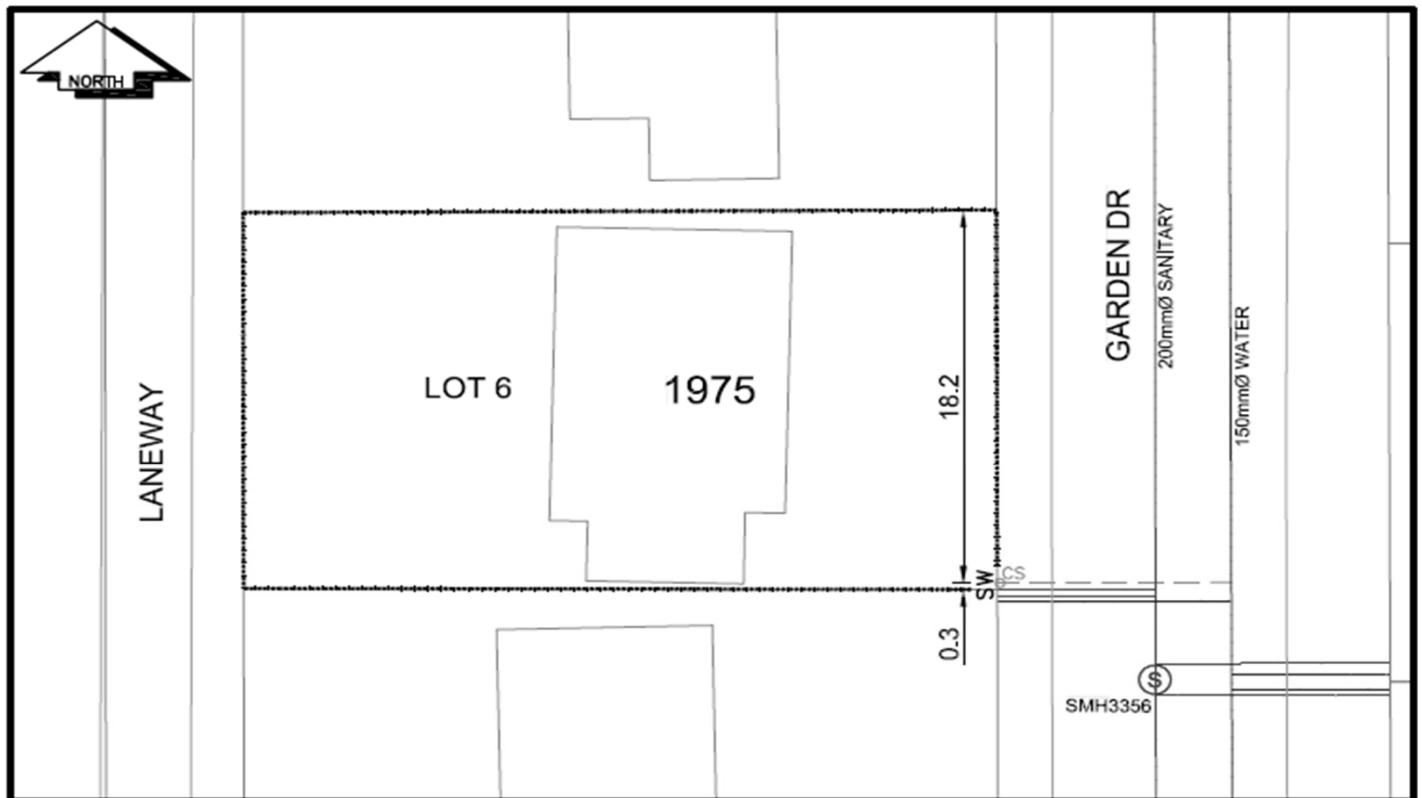

LEGEND:							
CS ^o	CURB STOP	--- W	WATER SERVICE	--- S	SANITARY SERVICE	--- o	STORM SERVICE
CO ^o	CLEAN OUT	---	GAS	---	ENCUMBRANCE		
⊗	WATER VALVE	⊗	FIRE HYDRANT				

NOT TO SCALE