



City of Prince George  
**History Sheet**

PID:	004902262
	004902289
	004902301
SD/MU:	
WO:	

Civic Address: 141 Cross St

Legal Description: Lot: 5 Block: 17 District Lot: 343 Plan: 1268


Service Type	Diameter (mm)	Material	Invert Elev at main (m)	Invert Elev at property line (m)	Invert Elev at service end (m)	Distance into property (m)	Installation Date
Sanitary	150mm	PVC	-	570.94	-	-	December 1995
Water	150mm	PVC	-	-	-	-	November 12996
Storm	200mm	Vit	-	570.81	-	-	December 1995

Service Connection Location	Sanitary (m)	Storm (m)
150mm Sanitary service connected to San MH5456	-	
200mm Storm service connected to Stm MH2071		

Power	Size	Communications	Size	Cable	Size	Gas	Size
BC Hydro	-	Telus	-	Shaw	-	FortisBC	-
Overhead Service		Overhead Service		Overhead Service			

Installed by:	Survey Date:	-
Comments:		

**NOT TO SCALE** The information contained herein is for internal use only.  
Not to be relied on unless confirmed by site inspection and/or investigation.

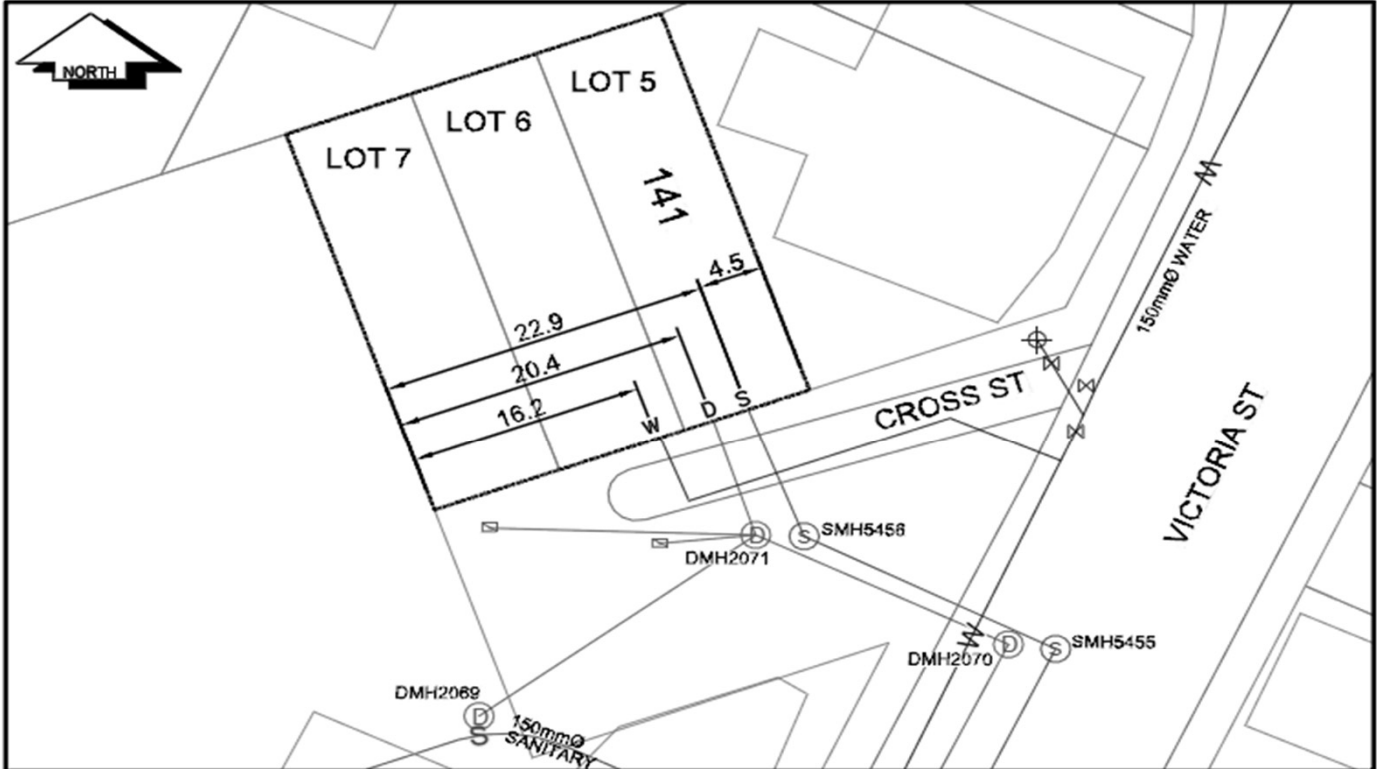

CURB STOP	WATER SERVICE	STORM SERVICE
CLEAN OUT	SANITARY SERVICE	GAS
WATER VALVE	FIRE HYDRANT	ENCUMBRANCE

**NOT TO SCALE**