

**City of Prince George  
HISTORY SHEET**

004909950  
776

SHEET NUMBER \_\_\_\_\_ Roll Number \_\_\_\_\_

Legal: LOT'S 5-0 BLOCK 81 D.L. 937 PLAN 752

Address: 253 KELLY ST.

Sanitary Connection: # 3381 SIZE 100 MM MATERIAL A.C. INV. 597.964 CONNECTED

Water Connection # 3120 SIZE 20 MM MATERIAL CU. METER \_\_\_\_\_ CONNECTED

Storm Connection: # \_\_\_\_\_ SIZE \_\_\_\_\_ MATERIAL \_\_\_\_\_ INV. \_\_\_\_\_ CONNECTED

Cash Receipt No's: WATER \_\_\_\_\_ SANITARY \_\_\_\_\_ STORM \_\_\_\_\_

CURB FROM PROPERTY LINE 4.877 M PAVEMENT WIDTH 10.363 M


B.C. HYDRO O/H UNDERGROUND CONNECTION \_\_\_\_\_

B.C. TELEPHONE O/H UNDERGROUND CONNECTION \_\_\_\_\_


INLAND GAS 1.524 M FROM WEST SIDE OF LANE.

Information Sheets: \_\_\_\_\_

Comments: WITH THAW WIRE.

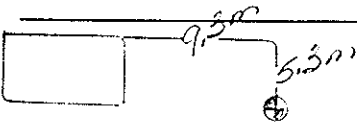

SITE PLAN N.T.S.

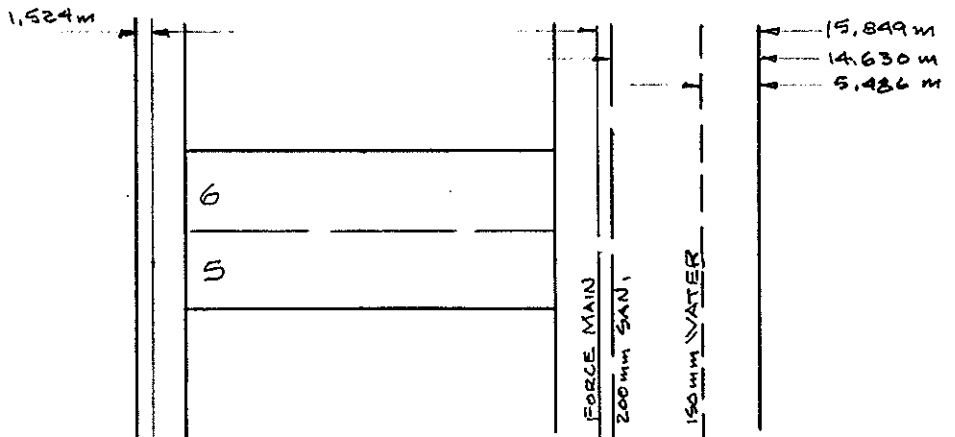

KELLY ST.