

**City of Prince George
HISTORY SHEET**

009909950
276

SHEET NUMBER

Roll Number

Legal: LOT'S 5-6 BLOCK 81 D.L. 937 PLAN 752

Address: 253 KELLY ST.

Sanitary Connection: # 3381 SIZE 100 MM MATERIAL A.C. INV. 597.964 CONNECTED

Water Connection # 3120 SIZE 20 MM MATERIAL CU. METER CONNECTED

Storm Connection: # SIZE MATERIAL INV. CONNECTED

Cash Receipt No's: WATER SANITARY STORM

CURB FROM PROPERTY LINE 4.877 M PAVEMENT WIDTH 10.363 M


B.C. HYDRO O/H UNDERGROUND CONNECTION

B.C. TELEPHONE O/H UNDERGROUND CONNECTION


INLAND GAS 1.524 M FROM WEST SIDE OF LANE.

Information Sheets:

Comments: WITH THAW WIRE.

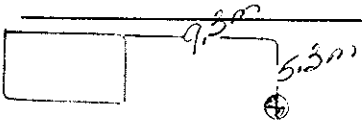

SITE PLAN N.T.S.

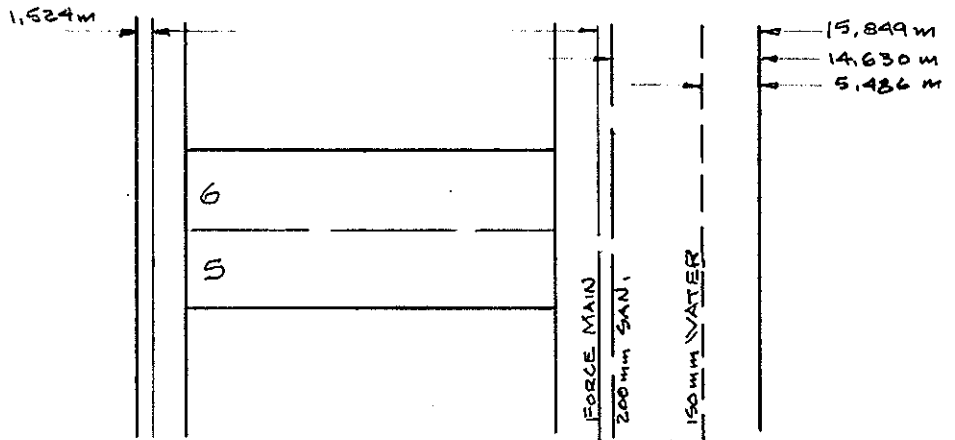

KELLY ST.