

# City of Prince George HISTORY SHEET

SHEET NUMBER **7401** Roll Number *00499/49*

Legal: LOT'S *53* BLOCK D.L. *2426* PLAN *20751*

Address: *4849 BLAZER RD.*

Sanitary Connection: # SIZE MATERIAL INV. CONNECTED

Water Connection # SIZE MATERIAL METER CONNECTED

Storm Connection: # SIZE MATERIAL INV. CONNECTED

Cash Receipt No's: WATER SANITARY STORM

CURB FROM PROPERTY LINE PAVEMENT WIDTH

B.C. HYDRO UNDERGROUND CONNECTION

B.C. TELEPHONE UNDERGROUND CONNECTION

INLAND GAS


Information Sheets:

Comments:

SITE PLAN N.T.S.

*BLAZER RD.*

*P/L*

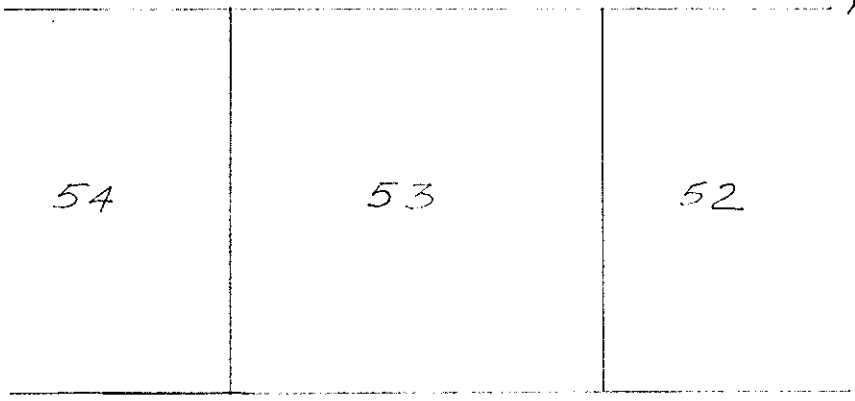

*P/L*