

**City of Prince George
HISTORY SHEET**

SHEET NUMBER **2725** Roll Number **004 932692**

Legal: LOT'S **9** BLOCK D.L. **4028** PLAN **24401**

Address: **2843 EAST AUSTIN ROAD.**

Sanitary Connection: # SIZE MATERIAL INV. CONNECTED

Water Connection # SIZE **3/4"** MATERIAL **CW.** METER CONNECTED

Storm Connection: # SIZE MATERIAL INV. CONNECTED

Cash Receipt No's: WATER SANITARY STORM

CURB FROM PROPERTY LINE PAVEMENT WIDTH

B.C. HYDRO **0/H. 8' pole offset** UNDERGROUND CONNECTION

B.C. TELEPHONE **0/H. 8' offset** UNDERGROUND CONNECTION



INLAND GAS **3'**

Information Sheets:

Comments:

SITE PLAN N.T.S.

EAST AUSTIN ROAD.

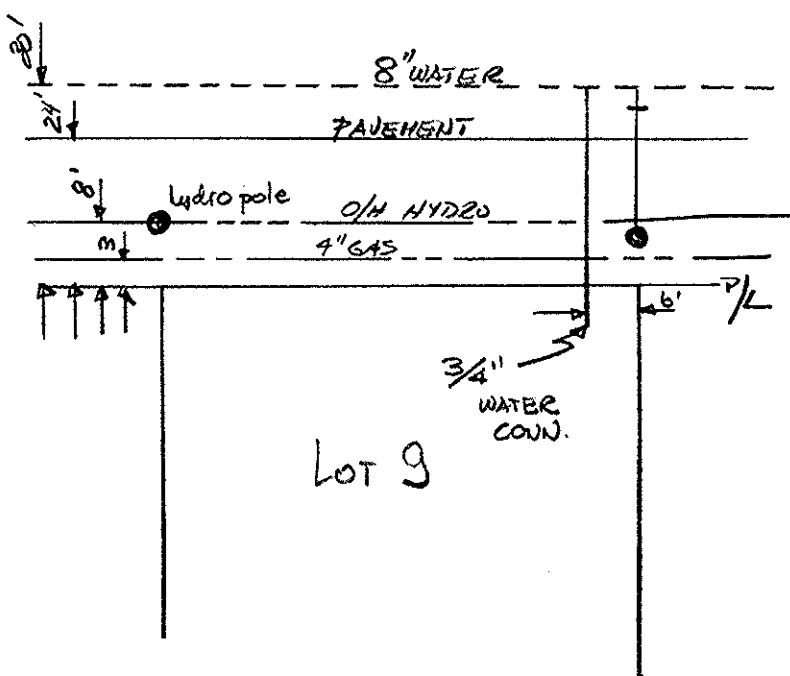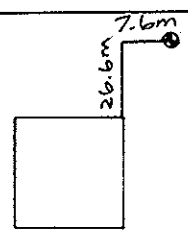

LOT 9

