

**City of Prince George
HISTORY SHEET**

S: 1948 670

SHEET NUMBER

Roll Number

688

Legal: LOT'S 19, 20 BLOCK 89 D.L. 937 PLAN 752

Address: 252 EWERT STREET

Sanitary Connection: # 1855 SIZE _____ MATERIAL _____ INV. _____ CONNECTED _____

Water Connection # 1253 SIZE 3/4" MATERIAL COPPER METER _____ CONNECTED _____

Storm Connection: # _____ SIZE _____ MATERIAL _____ INV. _____ CONNECTED _____

Cash Receipt No's: WATER _____ SANITARY _____ STORM _____

CURB FROM PROPERTY LINE _____ PAVEMENT WIDTH _____

B.C. HYDRO _____ UNDERGROUND CONNECTION _____


B.C. TELEPHONE _____ UNDERGROUND CONNECTION _____

INLAND GAS _____

Information Sheets:

Comments: **THE INFORMATION CONTAINED HEREIN IS FOR INTERNAL USE ONLY. NOT TO BE RELIED UPON UNLESS CONFIRMED BY SITE INSPECTION AND/OR INVESTIGATION.**

SITE PLAN N.T.S.

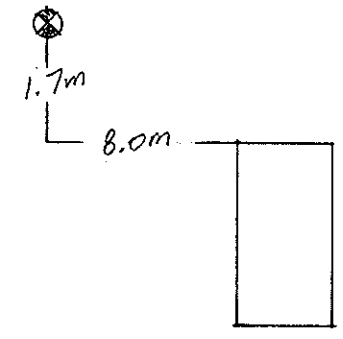

EWERT ST.

