
City of Prince George HISTORY SHEET

SHEET NUMBER		Roll Numb	oer 004953894
Legal: LOT'S \5	BLOCK	D.L. 2608 F	PLAN 20043
Address: 4393	FIRST AVE.		
Sanitary Connection: # 7331	SIZE \ OD W W MATERIAL	A.C. INV.	CONNECTED
Water Connection # 7331	SIZE ZOMM MATERIAL	CU, METER	CONNECTED
Storm Connection: #	SIZE MATERIAL	INV.	CONNECTED
Cash Receipt No's: WATER	SANITARY	STOP	RM -
CURB FROM PROPERTY LINE 5.791	w	PAVEMENT WIDTI	12.801
B.C. HYDRO U/G	UNDERGROU	ND CONNECTION	
B.C. TELEPHONE V/G	UNDERGRO	UND CONNECTION	
INLAND GAS AS SHOWN			
Information Sheets:			
Comments: WITH THAU	N WIRE;		

THE INFORMATION CONTAINED HEREIN IS FOR INTERNAL USE ONLY.

NOT TO BE RELIED UPON UNLESS CONFIRMED BY SITE INSPECTION AND/OR INVESTIGATION

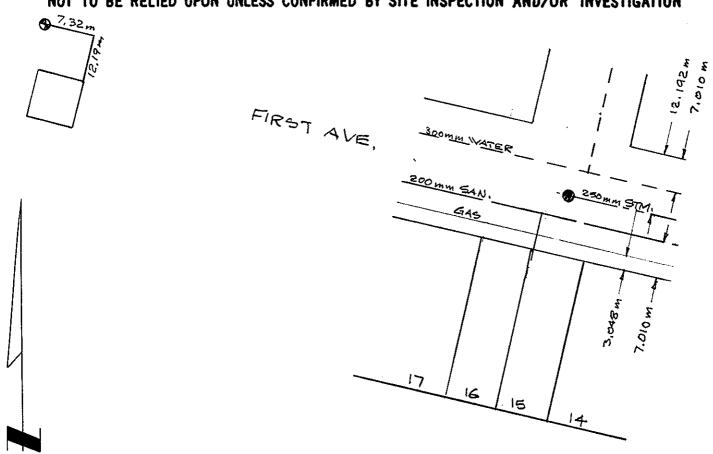

REPORT TO RECORDS

WATER SERVICE INFORMATION

Lot No Block D.L D.L.	
Address 4393 18T AVENUE	
Size of Connection	
Type of Connection ☐ Copper ☐ Iron	
Thaw Wire	
LOCATION SKETCH	
ield Location By Lith Bond Date June 1087 hecked by:	<i>i</i>