

**City of Prince George  
HISTORY SHEET**

5

SHEET NUMBER

Roll Number **004963792**

Legal: LOT'S **50** BLOCK D.L. **2610** PLAN **20829**

Address: **573 OTTER CRES.**

Sanitary Connection: # **8369** SIZE **100mm** MATERIAL **A.C.** INV. CONNECTED

Water Connection # **8369** SIZE **20mm** MATERIAL **C.U.** METER CONNECTED

Storm Connection: # SIZE MATERIAL INV. CONNECTED

Cash Receipt No's: WATER SANITARY STORM

CURB FROM PROPERTY LINE **4.877m** PAVEMENT WIDTH **10.383m**

B.C. HYDRO **U/G** UNDERGROUND CONNECTION



B.C. TELEPHONE **U/G** UNDERGROUND CONNECTION

INLAND GAS **AS SHOWN**

Information Sheets:

Comments:

**THE INFORMATION CONTAINED HEREIN IS FOR INTERNAL USE ONLY.  
NOT TO BE RELIED UPON UNLESS CONFIRMED BY SITE INSPECTION AND/OR INVESTIGATION**

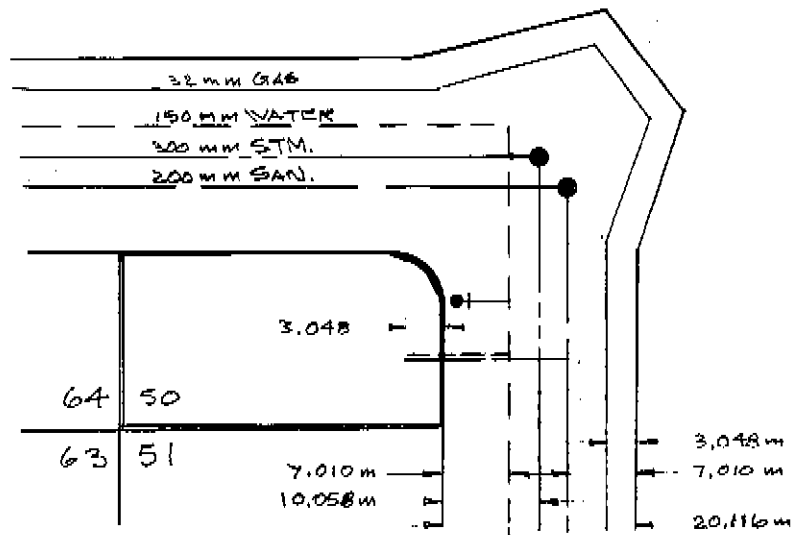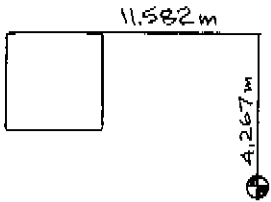

OTTER  
CRES.