

**City of Prince George  
HISTORY SHEET**

SHEET NUMBER

PID # 004963831

Legal: LOTS 20

BLOCK

D.L. 2608

PLAN 20043

Address:

4413 FIRST AVE.

Sanitary Connection: # SIZE 100 mm MATERIAL A.C. INV. CONNECTED

Water Connection: # SIZE 20 mm MATERIAL C.U. METER CONNECTED

Storm Connection: # SIZE mm MATERIAL INV. CONNECTED

Cash Receipt No's: WATER SANITARY STORM

CURB FROM PROPERTY LINE 5.791m

PAVEMENT WIDTH 12.801

B.C. HYDRO U/G UNDERGROUND CONNECTION


B.C. TELEPHONE U/G UNDERGROUND CONNECTION

INLAND GAS 3.048m FROM FE

Information Sheets:

Comments:

**THE INFORMATION CONTAINED HEREIN IS FOR INTERNAL USE ONLY.  
NOT TO BE RELIED UPON UNLESS CONFIRMED BY SITE INSPECTION AND/OR INVESTIGATION**

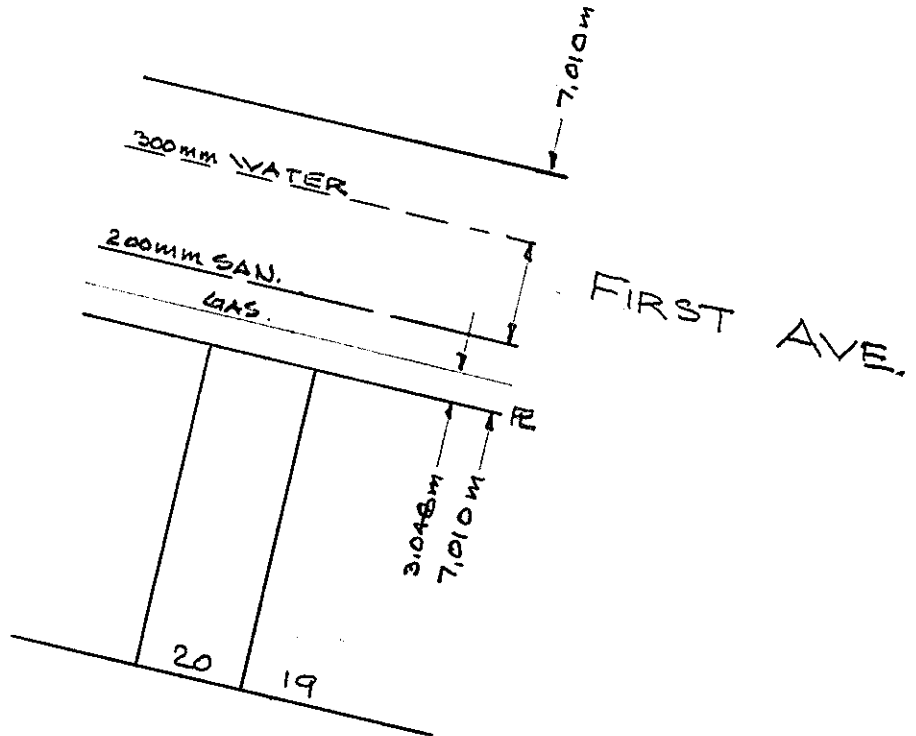

# REPORT TO RECORDS

WATER SERVICE INFORMATION C04963 831

Lot No. 20 Block      D.L. 2608


Address 4413 1ST AVENUE

Size of Connection  1/2"  3/4"  Other \_\_\_\_\_

Type of Connection  Copper  Iron

Thaw Wire  Yes  No P2 20043

## LOCATION SKETCH

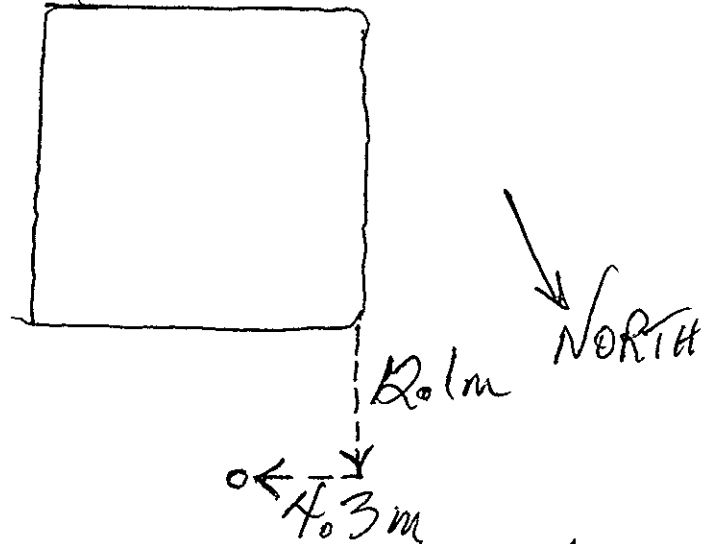

Field Location By W. Bond Date June 2/87

Checked by: \_\_\_\_\_