

# City of Prince George

## HISTORY SHEET

SHEET NUMBER

PID #

Legal: LOT'S

BLOCK

D.L. 1427

PLAN PG512

Address: 4051 MCRAE AVE ; 199 N OSPIKA BLVD

Sanitary Connection: #                      SIZE                      mm                      MATERIAL                      INV.                      CONNECTED

Water Connection: #                      SIZE                      mm                      MATERIAL                      METER                      CONNECTED

Storm Connection: #                      SIZE                      mm                      MATERIAL                      INV.                      CONNECTED

Cash Receipt No's:                      WATER                      SANITARY                      STORM

CURB FROM PROPERTY LINE                      PAVEMENT WIDTH

B.C. HYDRO                      UNDERGROUND CONNECTION


B.C. TELEPHONE                      UNDERGROUND CONNECTION

INLAND GAS

Information Sheets:

Comments:

**THE INFORMATION CONTAINED HEREIN IS FOR INTERNAL USE ONLY.  
NOT TO BE RELIED UPON UNLESS CONFIRMED BY SITE INSPECTION AND/OR INVESTIGATION**

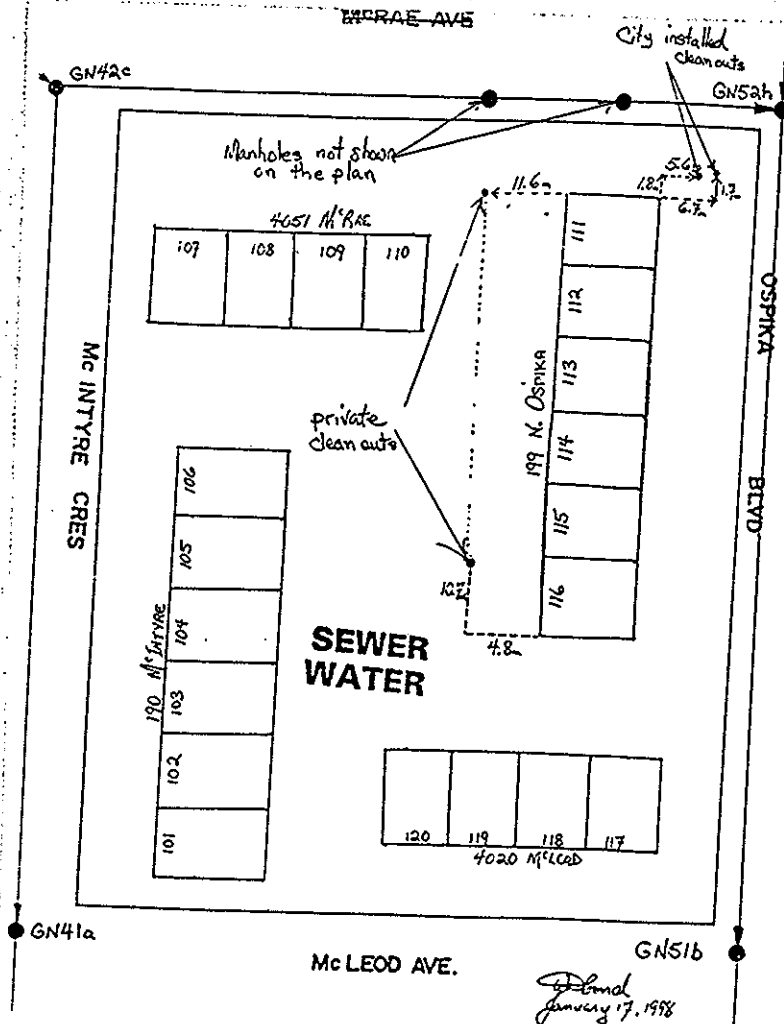

*David*  
January 17, 1998