


City of Prince George

HISTORY SHEET

SHEET NUMBER		PID #			
Legal:	LOTS	BLOCK	D.L. 1427	PLAN	PGS12
Address: 4051 McRAE AVE ; 199 N OSPIKA BLVD					
Sanitary Connection:	#	SIZE	mm	MATERIAL	INV. CONNECTED
Water Connection:	#	SIZE	mm	MATERIAL	METER CONNECTED
Storm Connection:	#	SIZE	mm	MATERIAL	INV. CONNECTED
Cash Receipt No's:	WATER	SANITARY	STORM		
CURB FROM PROPERTY LINE			PAVEMENT WIDTH		
B.C. HYDRO		UNDERGROUND CONNECTION			
B.C. TELEPHONE		UNDERGROUND CONNECTION			
INLAND GAS					
Information Sheets:					
Comments:					

**THE INFORMATION CONTAINED HEREIN IS FOR INTERNAL USE ONLY.
NOT TO BE RELIED UPON UNLESS CONFIRMED BY SITE INSPECTION AND/OR INVESTIGATION**

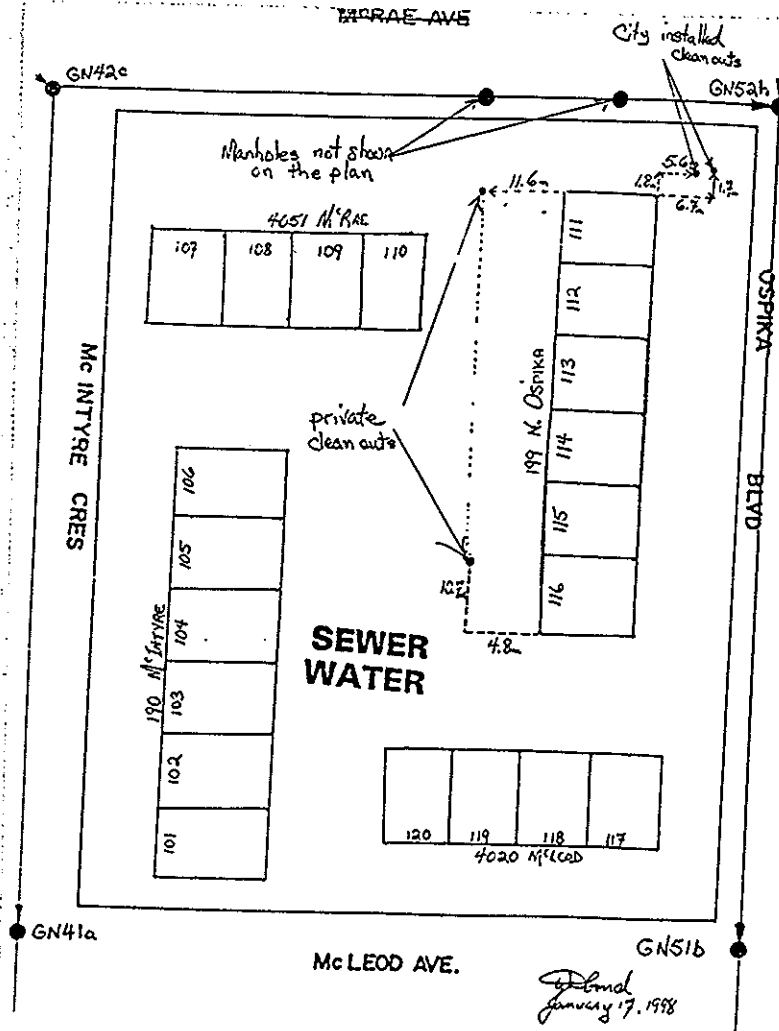

Deland
January 17, 1998