

City of Prince George

HISTORY SHEET

SHEET NUMBER _____ PID # _____

Legal: LOT'S _____ BLOCK _____ D.L. 1427 PLAN PG 512

Address: 4051 McRAE AVE ; 199 N OSPIKA BLVD

Sanitary Connection:	#	SIZE	mm	MATERIAL	INV.	CONNECTED
Water Connection:	#	SIZE	mm	MATERIAL	METER	CONNECTED
Storm Connection:	#	SIZE	mm	MATERIAL	INV.	CONNECTED

Cash Receipt No's: WATER _____ SANITARY _____ STORM _____

CURB FROM PROPERTY LINE _____ PAVEMENT WIDTH _____

B.C. HYDRO _____ UNDERGROUND CONNECTION _____


B.C. TELEPHONE _____ UNDERGROUND CONNECTION _____

INLAND GAS _____

Information Sheets: _____

Comments: _____

**THE INFORMATION CONTAINED HEREIN IS FOR INTERNAL USE ONLY.
NOT TO BE RELIED UPON UNLESS CONFIRMED BY SITE INSPECTION AND/OR INVESTIGATION**

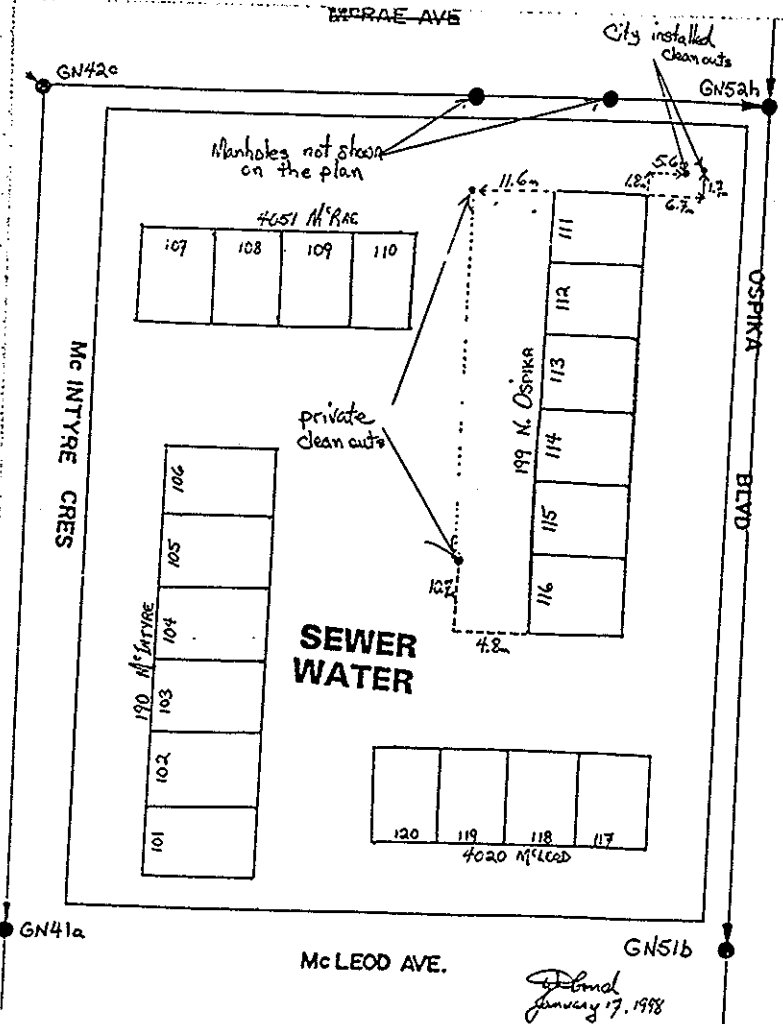

John
January 17, 1998