

City of Prince George

HISTORY SHEET

SHEET NUMBER

PID #

Legal: LOTS

BLOCK

D.L. 1427

PLAN PG512

Address: 4051 McRAE AVE ; 199 N OSPIKA BLVD

Sanitary Connection: # SIZE mm MATERIAL INV. CONNECTED

Water Connection: # SIZE mm MATERIAL METER CONNECTED

Storm Connection: # SIZE mm MATERIAL INV. CONNECTED

Cash Receipt No's: WATER SANITARY STORM

CURB FROM PROPERTY LINE PAVEMENT WIDTH

B.C. HYDRO UNDERGROUND CONNECTION


B.C. TELEPHONE UNDERGROUND CONNECTION

INLAND GAS

Information Sheets:

Comments:

**THE INFORMATION CONTAINED HEREIN IS FOR INTERNAL USE ONLY.
NOT TO BE RELIED UPON UNLESS CONFIRMED BY SITE INSPECTION AND/OR INVESTIGATION**

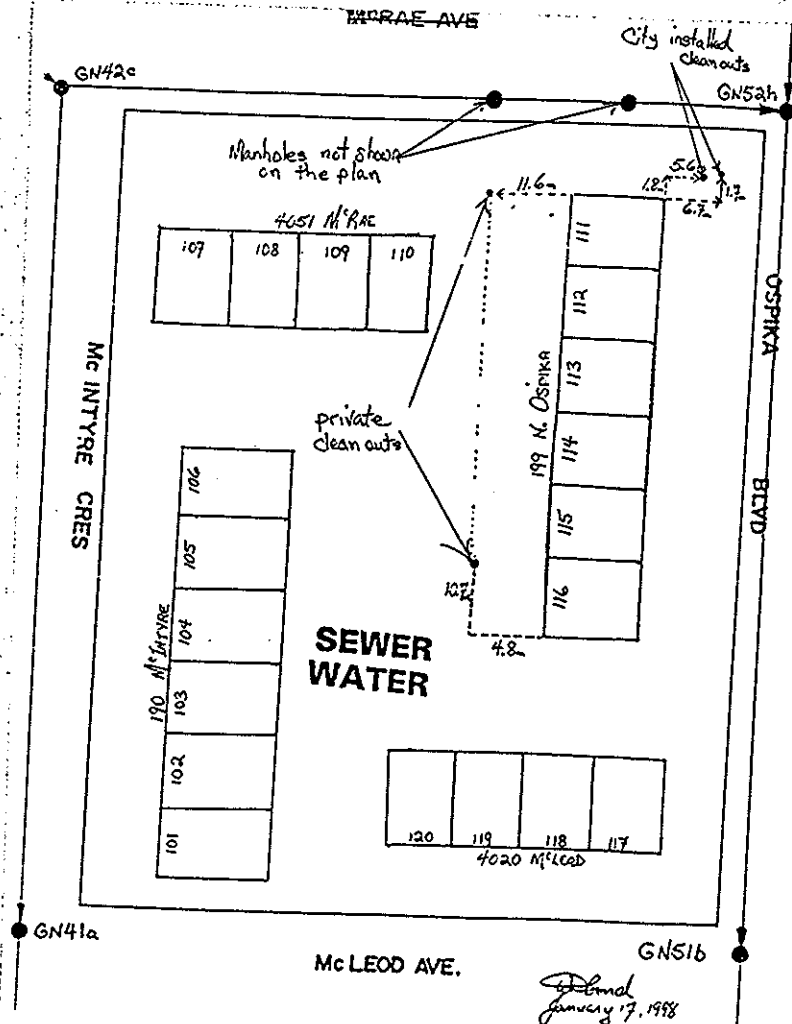

David
January 17, 1988