

City of Prince George HISTORY SHEET

SHEET NUMBER

Roll Number *005026628*

Legal: LOT'S *3* BLOCK D.L. *632* PLAN *23807*

Address: *1439 N. BLACKBURN RD.*

Sanitary Connection: # *11471* SIZE *4"* MATERIAL *A.C.* INV. CONNECTED

Water Connection # *11471* SIZE *3/4"* MATERIAL *Cu.* METER CONNECTED

Storm Connection: # SIZE MATERIAL INV. CONNECTED

Cash Receipt No's: WATER *0675* SANITARY *0674* STORM

CURB FROM PROPERTY LINE PAVEMENT WIDTH

B.C. HYDRO UNDERGROUND CONNECTION

B.C. TELEPHONE UNDERGROUND CONNECTION


INLAND GAS

Information Sheets:

Comments:

**THE INFORMATION CONTAINED HEREIN IS FOR INTERNAL
USE ONLY. NOT TO BE RELIED UPON UNLESS CONFIRMED
BY SITE INSPECTION AND/OR INVESTIGATION.**

SITE PLAN N.T.S.

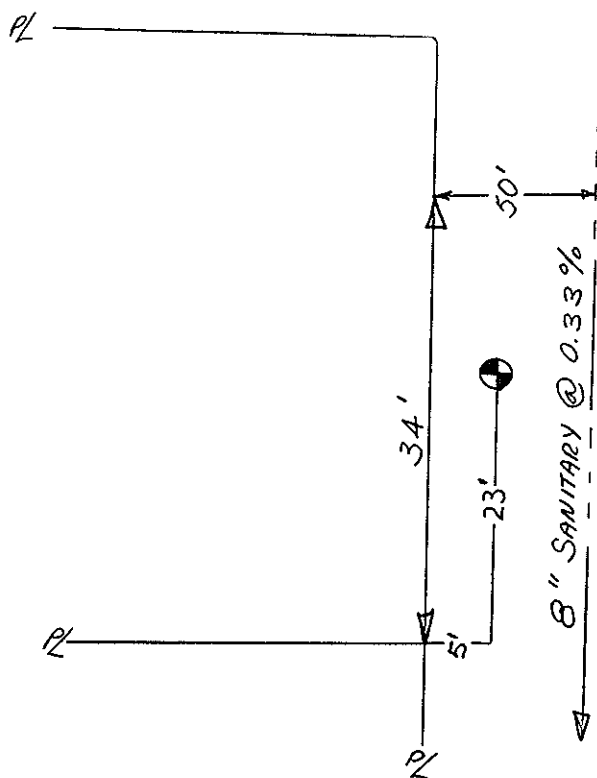

NORTH BLACKBURN RD.