

# City of Prince George HISTORY SHEET

SHEET NUMBER

Roll Number 305 026636

Legal: LOT'S 7 BLOCK D.L. 6.32 PLAN 23807

Address: 1487 N. BLACKBURN RD.

Sanitary Connection: # 11475 SIZE 4" MATERIAL A.C. INV. CONNECTED

Water Connection # 11475 SIZE 3/4" MATERIAL CU METER CONNECTED

Storm Connection: # SIZE MATERIAL INV. CONNECTED

Cash Receipt No's: WATER 0675 SANITARY 0674 STORM

CURB FROM PROPERTY LINE PAVEMENT WIDTH

B.C. HYDRO UNDERGROUND CONNECTION


B.C. TELEPHONE UNDERGROUND CONNECTION

INLAND GAS

Information Sheets:

Comments:

SITE PLAN N.T.S.

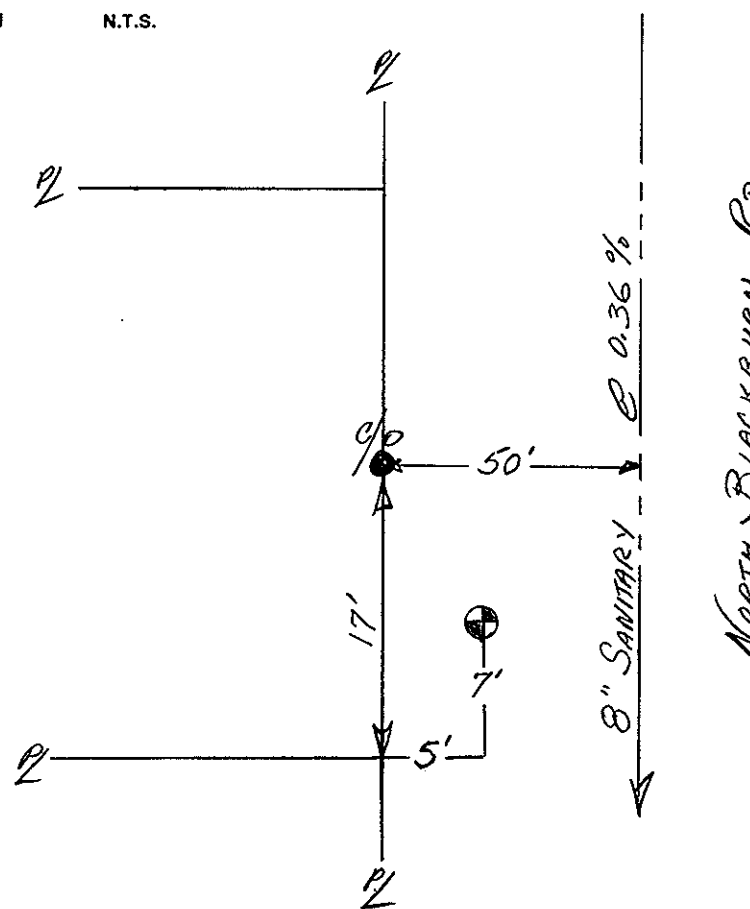

North Blackburn Rd