



City of Prince George
History Sheet

PID:	005038472
SD/MU:	
WO:	

Civic Address: 2121 Queensway

Legal Description: Lot: 9 Block: 1 District Lot: 417 Plan: 1409


Service Type	Diameter (mm)	Material	Invert Elev at main (m)	Invert Elev at property line (m)	Invert Elev at service end (m)	Distance into property (m)	Installation Date
Sanitary	N/A	N/A	-	-	-	-	-
Water	20mm	Copper	-	-	-	-	January 1955
Storm	N/A	N/A	-	-	-	-	

Service Connection Location			Sanitary (m)	Storm (m)
Distance from downstream San MH	-	towards upstream San MH	-	
Distance from downstream Stm MH	-	towards upstream Stm MH	-	

Power	Size	Communications	Size	Cable	Size	Gas	Size
BC Hydro	-	Telus	-	Shaw	-	FortisBC	-
Overhead Service		Overhead Service		Overhead Service			

Installed by:	Survey Date:	-
Comments: Water service location confirmed October 2016		

NOT TO SCALE The information contained herein is for internal use only.
Not to be relied on unless confirmed by site inspection and/or investigation.

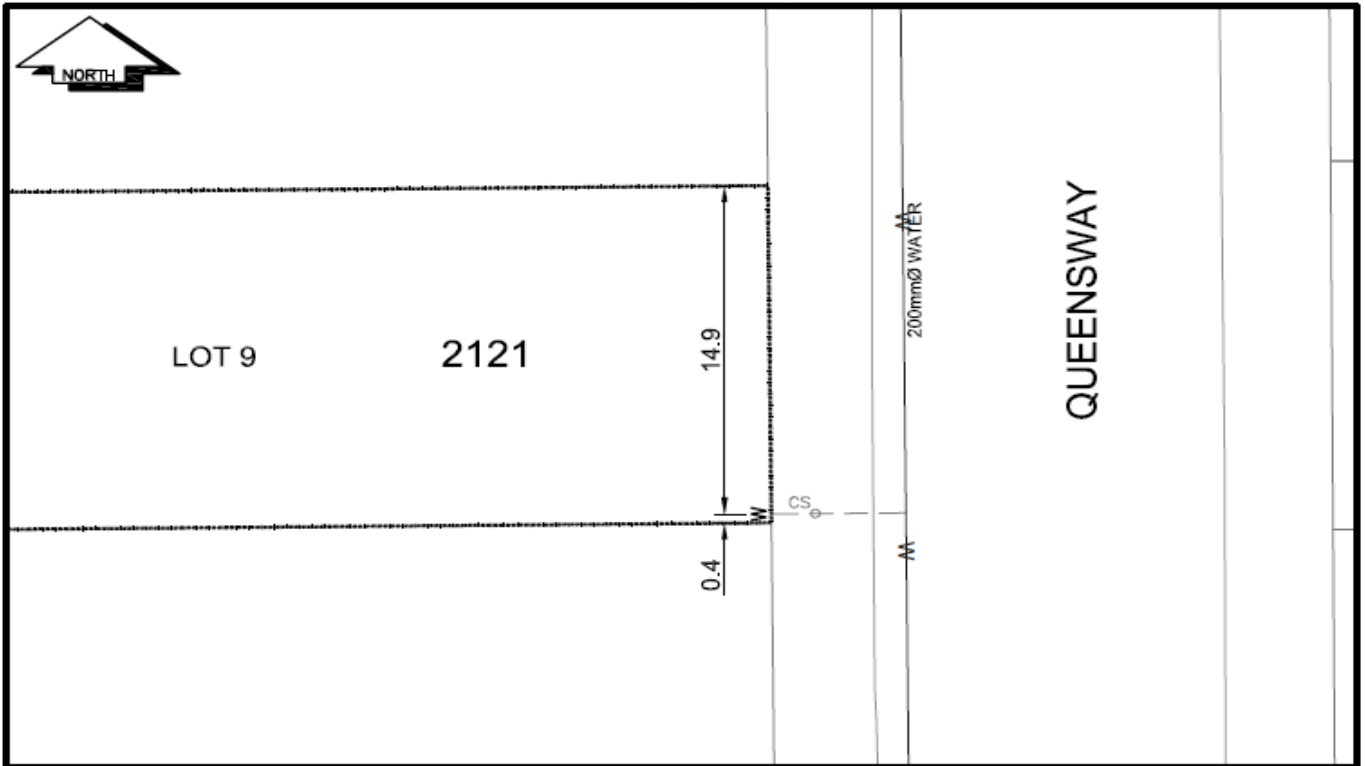

LEGEND:	CS	CURB STOP	---	W	WATER SERVICE	---	D	STORM SERVICE
	CO	CLEAN OUT	---	S	SANITARY SERVICE	---	G	GAS

NOT TO SCALE