

**City of Prince George
HISTORY SHEET**

05051962
983

SHEET NUMBER _____ Roll Number _____

Legal: LOT'S 19-20 BLOCK 79 D.L. 937 PLAN 752

Address: 254 N. NICHOLSON ST.

Sanitary Connection: # 3282 SIZE 100 mm MATERIAL A.C. INV. 602.195 CONNECTED

Water Connection # 3315 SIZE 20 mm MATERIAL C.U. METER _____ CONNECTED

Storm Connection: # _____ SIZE _____ MATERIAL _____ INV. _____ CONNECTED

Cash Receipt No's: WATER _____ SANITARY _____ STORM _____

CURB FROM PROPERTY LINE 4.877 m PAVEMENT WIDTH 10.363 m


B.C. HYDRO O/H UNDERGROUND CONNECTION

B.C. TELEPHONE O/H UNDERGROUND CONNECTION


INLAND GAS 1.524 m FROM R IN LANE.

Information Sheets: _____

Comments: WITH THAW WIRE.

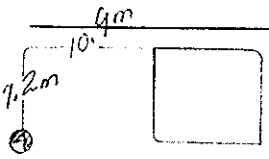

SITE PLAN N.T.S.

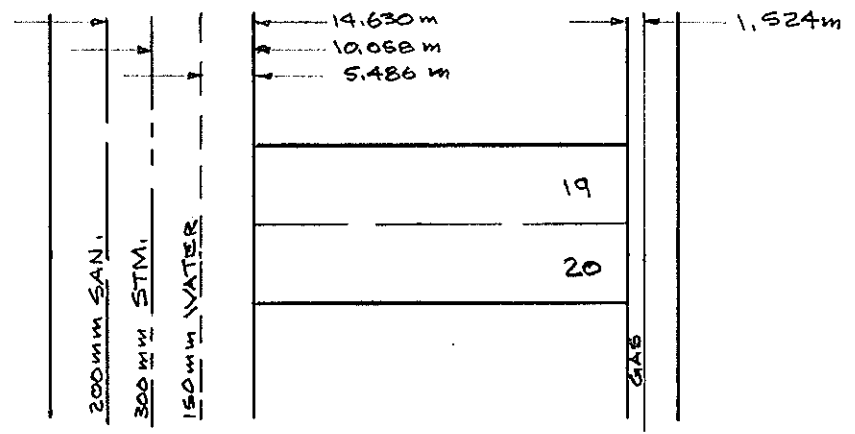

N. NICHOLSON ST.