

**City of Prince George
HISTORY SHEET**

005077061

SHEET NUMBER

Roll Number

Legal: LOT'S *A* BLOCK D.L. *343* PLAN *18748*

Address: *1320 1ST AVE. CNR STATION.*

Sanitary Connection: # *1405* SIZE *100MM* MATERIAL *A.C.* INV. *569.019* CONNECTED *YES*

Water Connection # SIZE *150MM* MATERIAL *IRON* METER CONNECTED

Storm Connection: # *292* SIZE *200MM* MATERIAL *C.I.* INV. *568.650* CONNECTED

Cash Receipt No's: WATER SANITARY *382* STORM *383*

CURB FROM PROPERTY LINE PAVEMENT WIDTH

B.C. HYDRO *YES* UNDERGROUND CONNECTION *YES*


B.C. TELEPHONE *YES* UNDERGROUND CONNECTION *YES*

INLAND GAS *YES*

Information Sheets:

Comments:

SITE PLAN N.T.S.

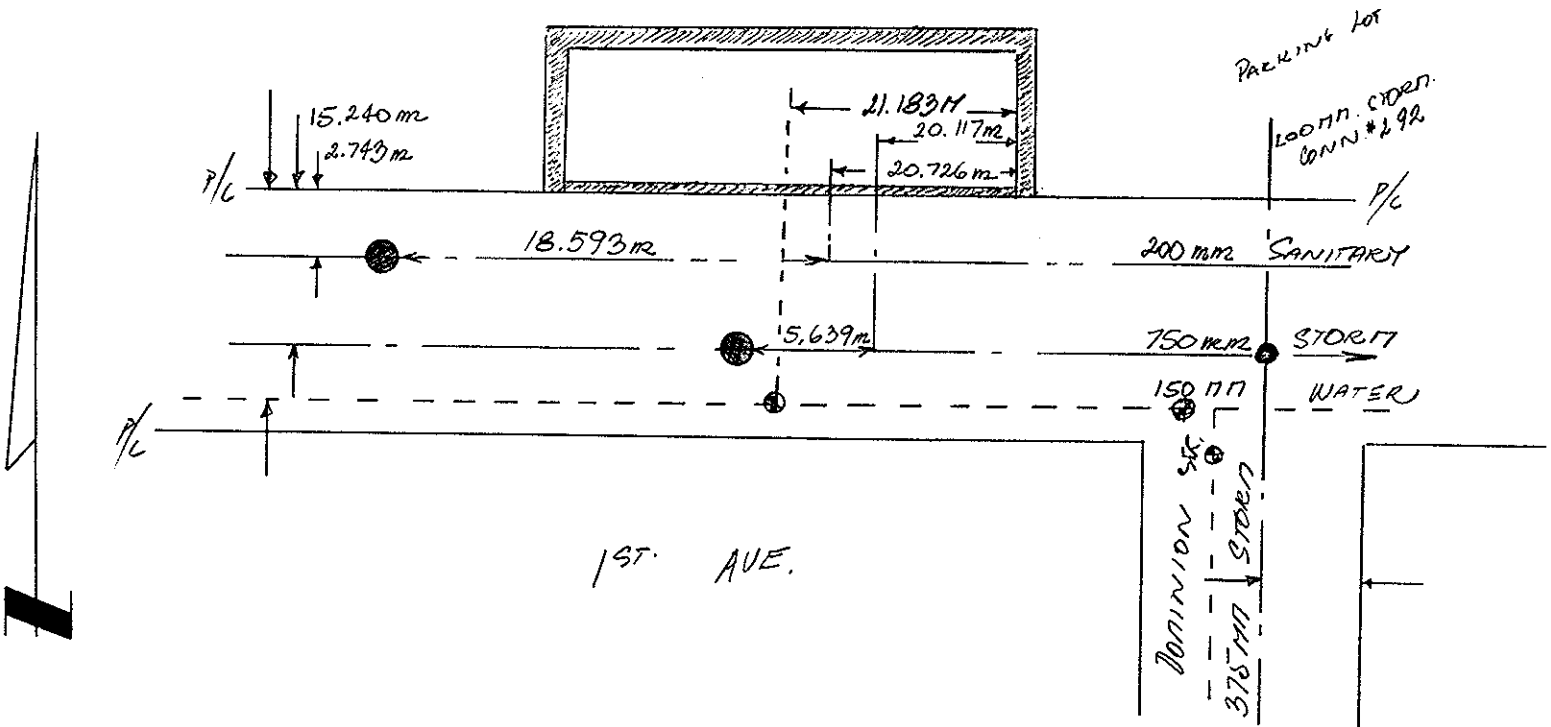

SANITARY & STORM INVERT CALCULATIONS

SANITARY

STORM

279

292

1. Distance from M.H. <u>63-1</u> to connection point is <u>61</u> ft. toward M.H. <u>63-2</u>			
2. Calculated invert of main to conn. pt. is _____			
3. Main Size at connection point is <u>200 mm</u>			
4. Conn. invert at half diameter (Crown) of main is _____			
5. Add to (4) allowance of 0.2 for 1/8 bend. Adjusted invert now _____			
6. Dist. from main to P/L equals <u>2.743</u> ft. at <u>2mm/1m</u> gives rise of <u>0.055</u>			
7. Item (5) plus (6) equals Calculated Elev. of conn. inv. at P/L equals _____			
13. Elev. of ref. hub top _____	<u>570.783</u>	<u>570.783</u>	<u>569.634</u>
14. Elev. of invert at P/line _____	<u>569.020</u>	<u>568.650</u>	<u>568.083</u>
15. Difference or cut below at property line _____	<u>1.703</u>	<u>2.133</u>	
16. Survey Date <u>27 JANUARY</u> 19 <u>70</u> Book Ref. <u>291-21</u> by <u>CSE</u>	<u>CSE</u>	<u>CSE</u>	
17. Cut at P/Line in feet and inches _____	<u>1.737H</u>	<u>2.133</u>	<u>1.548</u>

Sanitary History:

MARCH 2/72 MAIN LINE FROZEN BTWN MH 63-1 - 63-2

Water History:

NOV. 20/79 FIELD LOCATION : BY R.H.
SEPT. 19/83 WATER LOCATION DONE BY: V6.

Storm History:

NOV. 29/70 AS BUILT. Conn. N^o 279
AUG. 18/70 AS BUILT. Conn. N^o 292

**City of Prince George
HISTORY SHEET**

005077061

SHEET NUMBER

Roll Number

Legal: LOT'S *A* BLOCK D.L. *343* PLAN *1874B*

Address: *1300 1st. AVE. (CN OFFICE)*

Sanitary Connection: # SIZE MATERIAL INV. CONNECTED

Water Connection # *1894* SIZE *40mm* MATERIAL *Copper* METER *YES* CONNECTED *YES*

Storm Connection: # SIZE MATERIAL INV. CONNECTED

Cash Receipt No's: WATER SANITARY STORM

CURB FROM PROPERTY LINE PAVEMENT WIDTH

B.C. HYDRO UNDERGROUND CONNECTION

B.C. TELEPHONE UNDERGROUND CONNECTION

INLAND GAS

Information Sheets:

Comments: *FOR MORE INFORMATION SEE ENG. DWG. 3650*

