



City of Prince George HISTORY SHEET

SHEET NUMBER	Roll Number 005093058			
Legal:	LOT'S 310	BLOCK	D.L. 2611	PLAN 21607
Address:	2293 TAPPING STREET			
Sanitary Connection:	# 9500	SIZE 100 mm	MATERIAL A.C.	INV. 75.09 CONNECTED
Water Connection:	# 9500	SIZE 20 mm	MATERIAL Copper	METER CONNECTED
Storm Connection:	#	SIZE	MATERIAL	INV. CONNECTED
Cash Receipt No's:	WATER	SANITARY	STORM	
CURB FROM PROPERTY LINE	4.877 m		PAVEMENT WIDTH	10.363 m
B.C. HYDRO	U/G	UNDERGROUND CONNECTION		
B.C. TELEPHONE	U/G	UNDERGROUND CONNECTION		
INLAND GAS	AS SHOWN			
Information Sheets:	WITH THAW WIRE;			
Comments:	WATER and SANITARY Conn. is CENTRED on LOT			

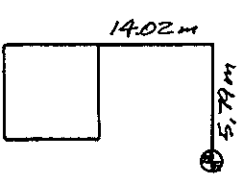

SITE PLAN N.T.S.

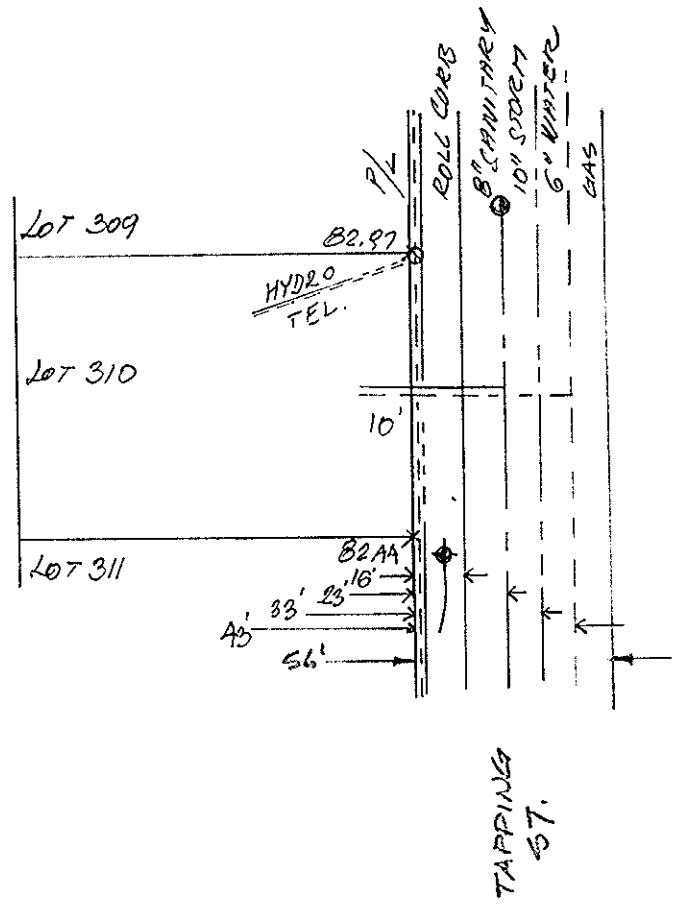

TAPPING ST.