



City of Prince George
History Sheet

PID:	005099609
MU:	101476
WO:	77778

Civic Address: 1327 Clubhouse Dr

Legal Description: Lot: 26 District Lot: 4377 Plan: 1329


Service Type	Diameter (mm)	Material	Invert Elev at main (m)	Invert Elev at property line (m)	Invert Elev at service end (m)	Distance into property (m)	Installation Date
Sanitary	N/A	N/A	-	-	-	-	-
Water	25mm	Copper	-	-	-	as shown	September 2014
Storm	N/A	N/A	-	-	-	-	-

Service Connection Location			Sanitary (m)	Storm (m)
Distance from downstream San MH	-	towards upstream San MH	-	-
Distance from downstream Stm MH	-	towards upstream Stm MH	-	-

Power	Size	Communications	Size	Cable	Size	Gas	Size
BC Hydro	-	Telus	-	Shaw	-	FortisBC	-
Overhead Service		Overhead Service		Overhead Service			

Installed by:	City of Prince George forces	Survey Date:	-
Comments:	City forces installed to property line. Onsite waterline as per design by L&M engineering. Service end capped and staked.		

**NOT TO SCALE The information contained herein is for internal use only.
Not to be relied on unless confirmed by site inspection and/or investigation.**

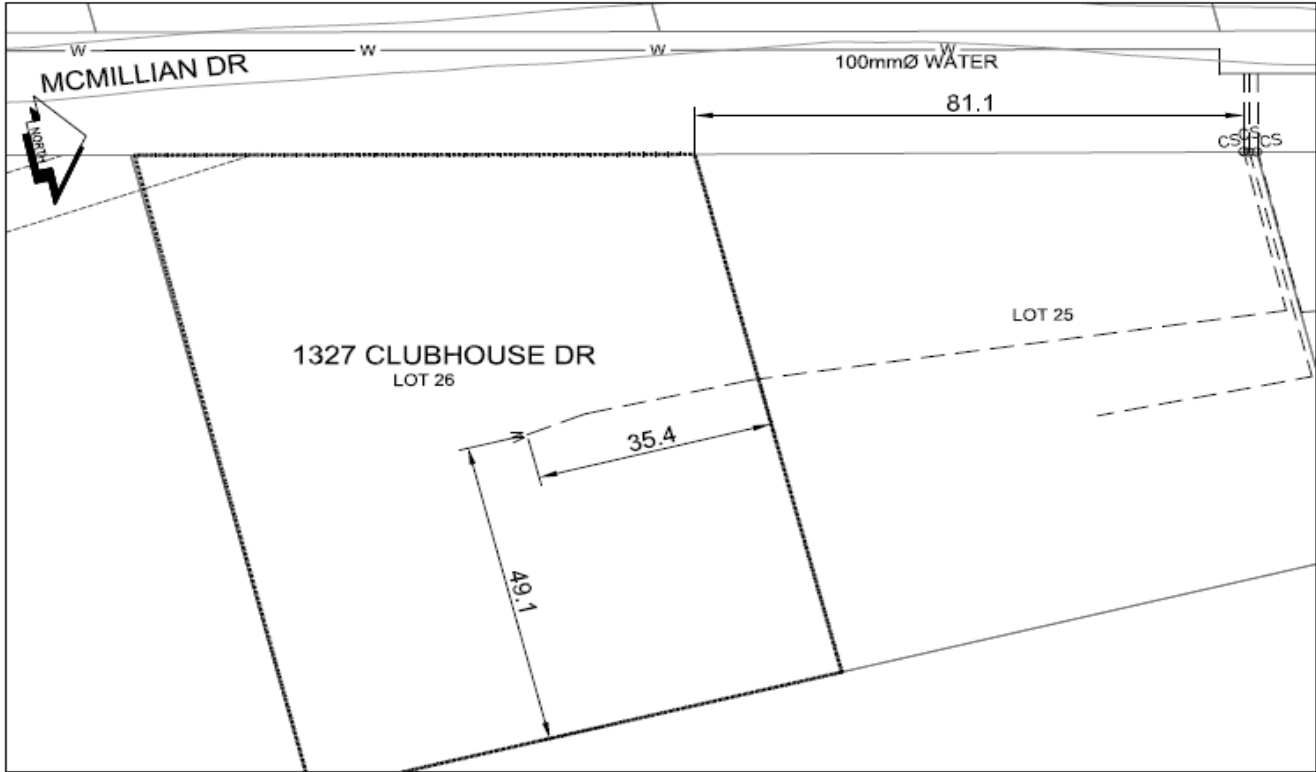

CS	CURB STOP	---	W	WATER SERVICE	---	S	SANITARY SERVICE	---	G	GAS
CO	CLEAN OUT	---			---			---		

NOT TO SCALE