

City of Prince George HISTORY SHEET

FL

SHEET NUMBER

Roll Number 005009051

Legal: LOT'S 147 BLOCK D.L. 2507 PLAN 20259

Address: 1036 NELSON CRESENT

Sanitary Connection: # 8237 SIZE 100 mm MATERIAL A.C. INV. CONNECTED

Water Connection # 8237 SIZE 20 mm MATERIAL CUBRA METER CONNECTED

Storm Connection: # _____ SIZE _____ MATERIAL _____ INV. CONNECTED

Cash Receipt No's: WATER _____ SANITARY _____ STORM _____

CURB FROM PROPERTY LINE _____ PAVEMENT WIDTH _____

B.C. HYDRO _____ UNDERGROUND CONNECTION _____


B.C. TELEPHONE _____ UNDERGROUND CONNECTION _____

INLAND GAS _____

Information Sheets: _____

Comments: _____


**THE INFORMATION CONTAINED HEREIN IS FOR INTERNAL USE ONLY.
NOT TO BE RELIED UPON UNLESS CONFIRMED BY SITE INSPECTION AND/OR INVESTIGATION**

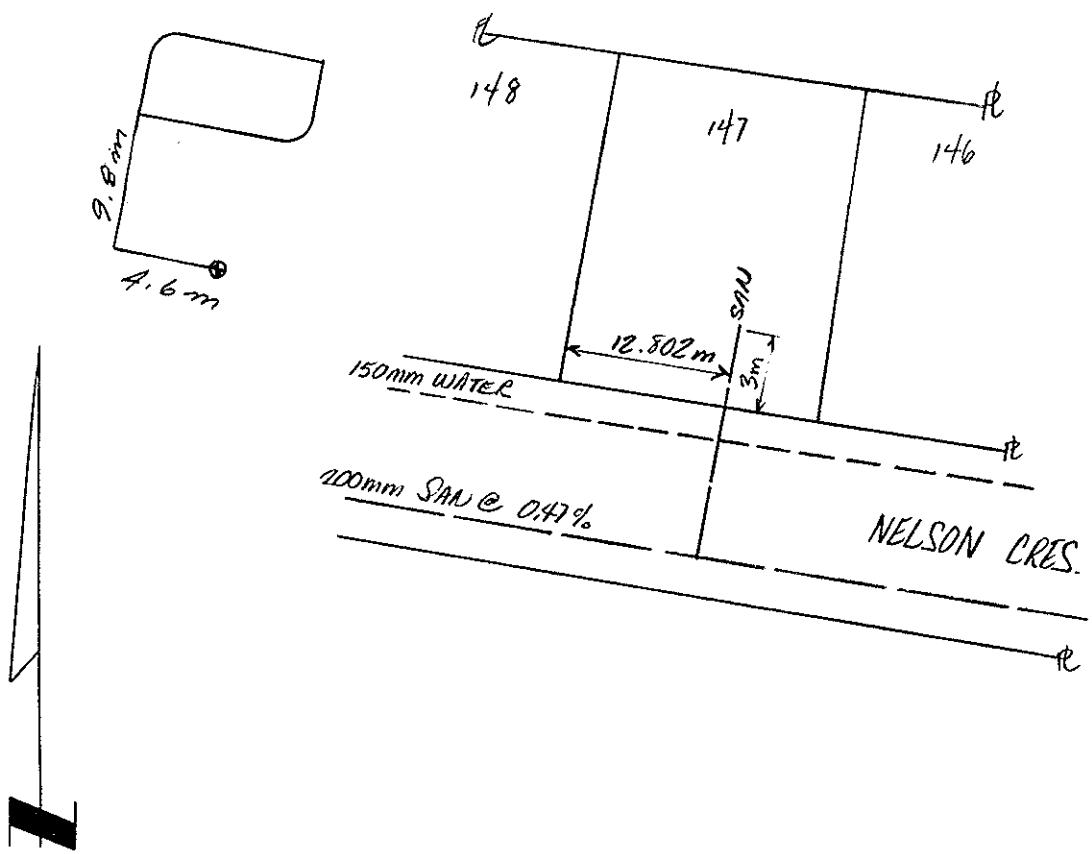

005099951

REPORT TO RECORDS**WATER SERVICE INFORMATION**

Lot No. _____ Block _____ D.L. _____

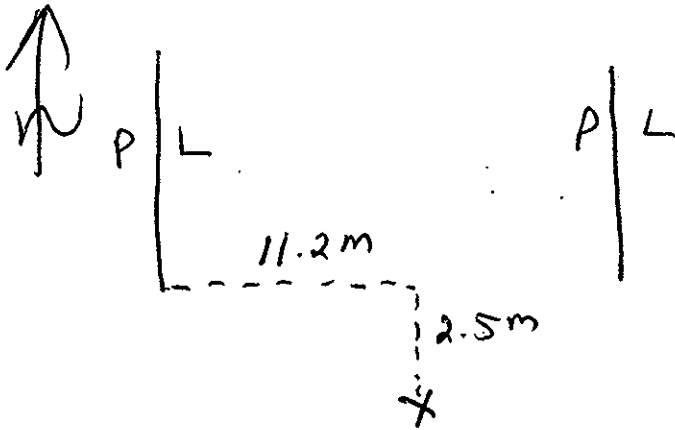Address 1036 Nelson CresSize of Connection 1/2" 3/4" Other _____Type of Connection Copper IronThaw Wire Yes No**LOCATION SKETCH**Field Location By J. Hasler Date Aug 23-02

Checked by: _____

REPORT TO RECORDS

SEWER SERVICE INFORMATION

Lot No. _____ Block _____ D.L. _____


Address 1036 Nelson Cres

Size of Connection 100mm 150mm 200mm Other _____

Type of Connection Transite PVC Other _____

Type of Cap Transite Cast Iron

LOCATION SKETCH

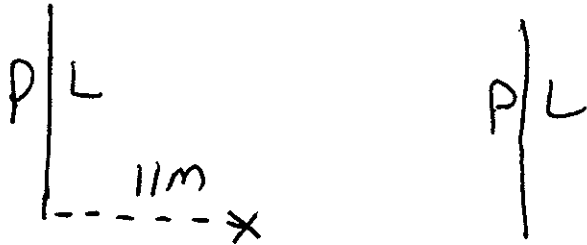

Field Location By *J. Handke* Date *Aug 22-02*

Checked by Foreman - Sewer Division _____