

**City of Prince George  
HISTORY SHEET**

005/00/01  
178  
186

SHEET NUMBER

Roll Number

Legal: LOT'S 11-13                      BLOCK 11                      D.L. 932                      PLAN 796

Address: 2226 PINE STREET

Sanitary Connection: # 6688                      SIZE 100mm                      MATERIAL A.C.                      INV. 566.792                      CONNECTED

Water Connection # 6721                      SIZE 20mm                      MATERIAL C.U.                      METER                      CONNECTED

Storm Connection: #                      SIZE                      MATERIAL                      INV.                      CONNECTED

Cash Receipt No's:                      WATER                      SANITARY 143                      STORM

CURB FROM PROPERTY LINE 5.791 m                      PAVEMENT WIDTH 12.801 m

B.C. HYDRO                      O/H                      UNDERGROUND CONNECTION


B.C. TELEPHONE                      O/H                      UNDERGROUND CONNECTION

INLAND GAS 4.572 m FROM R.

Information Sheets:

Comments: WITH THAW WIRE.

SITE                      PLAN                      N.T.S.

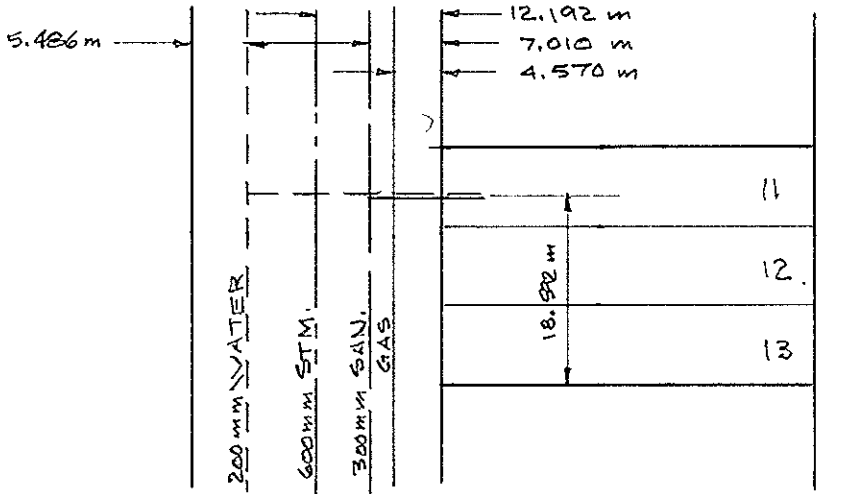

PINE ST.