

City of Prince George HISTORY SHEET

5

SHEET NUMBER

Roll Number 005107008

Legal: LOT'S *PCL 2* BLOCK D.L. *343* PLAN *1268*

Address: *1881 RIVER RD. (DE SAN DIESEL)*

Sanitary Connection: # SIZE MATERIAL INV. CONNECTED

Water Connection # SIZE MATERIAL METER CONNECTED

Storm Connection: # SIZE MATERIAL INV. CONNECTED

Cash Receipt No's: WATER SANITARY STORM

CURB FROM PROPERTY LINE PAVEMENT WIDTH

B.C. HYDRO UNDERGROUND CONNECTION


B.C. TELEPHONE UNDERGROUND CONNECTION

INLAND GAS

Information Sheets:

Comments: *FOR MORE INFORMATION SEE ENT. DWG. 3650*

SITE PLAN N.T.S.

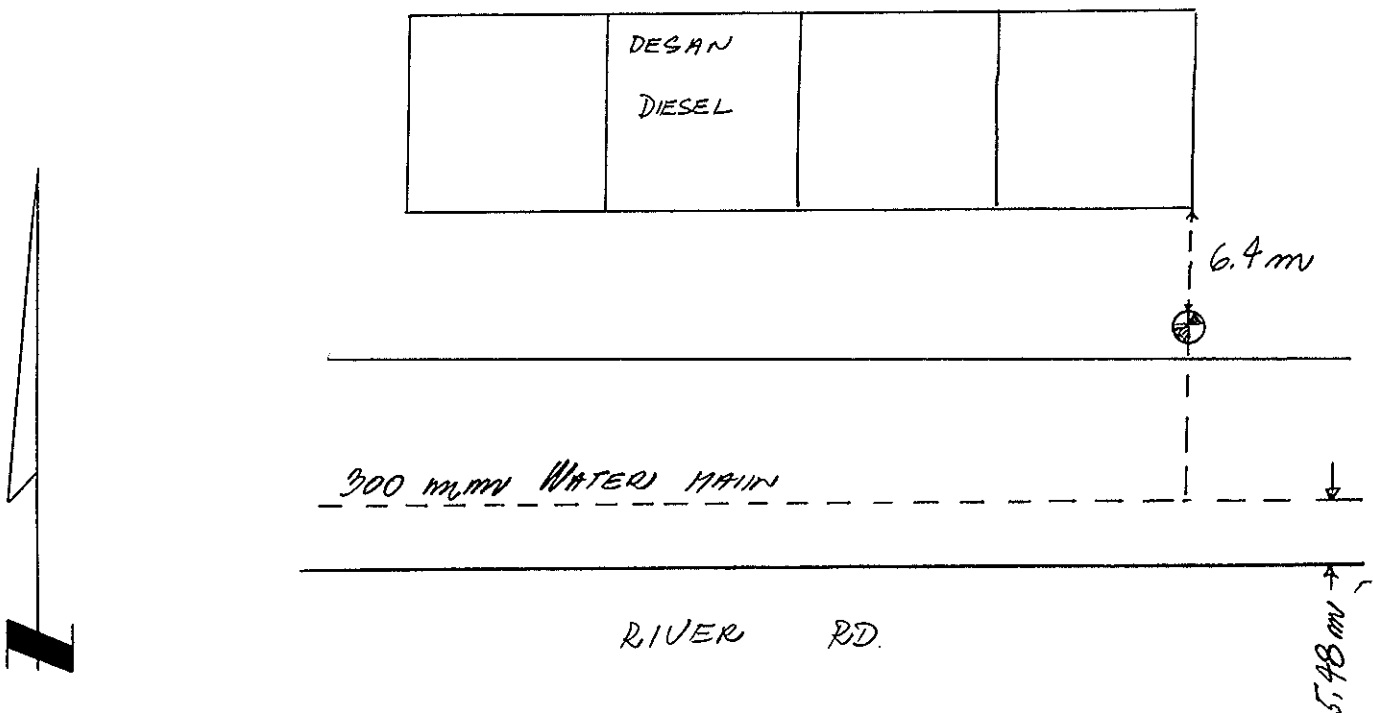

City of Prince George
HISTORY SHEET

005101000-1 S
96-71

SHEET NUMBER _____ Roll Number _____

Legal: LOT'S PC L Z BLOCK _____ D.L. 343 PLAN 1268

Address: 1988 - 1ST AVENUE

Sanitary Connection: # _____ SIZE 100mm MATERIAL PVC INV. _____ CONNECTED _____

Water Connection # _____ SIZE 50mm MATERIAL CU METER _____ CONNECTED _____

Storm Connection: # _____ SIZE 200mm MATERIAL _____ INV. _____ CONNECTED _____

Cash Receipt No's: WATER 19159 SANITARY 19159 STORM 19159

CURB FROM PROPERTY LINE _____ PAVEMENT WIDTH _____

3.C. HYDRO _____ UNDERGROUND CONNECTION _____



3.C. TELEPHONE _____ UNDERGROUND CONNECTION _____

LAND GAS _____

Information Sheets: _____

Comments: WITH THAW WIRE.

THE INFORMATION CONTAINED HEREIN IS FOR INTERNAL USE ONLY.
NOT TO BE RELIED UPON UNLESS CONFIRMED BY SITE INSPECTION AND/OR INVESTIGATION

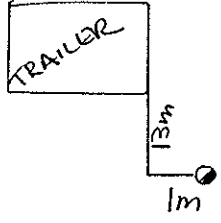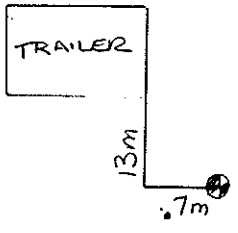

**City of Prince George
HISTORY SHEET**

005107008-2
S

SHEET NUMBER

Roll Number

Legal: LOT'S BLOCK D.L. PLAN

Address: *780 1st AVE. NORCANO DISTRIBUTERS LTD.*

Sanitary Connection: # SIZE MATERIAL INV. CONNECTED

Water Connection # SIZE *20mm* MATERIAL *Copper* METER CONNECTED

Storm Connection: # SIZE MATERIAL INV. CONNECTED

Cash Receipt No's: WATER *2773* SANITARY STORM

CURB FROM PROPERTY LINE PAVEMENT WIDTH

B.C. HYDRO UNDERGROUND CONNECTION


B.C. TELEPHONE UNDERGROUND CONNECTION

INLAND GAS

Information Sheets:

Comments: *FOR MORE INFORMATION SEE ENV. DUB. 3650*

SITE PLAN N.T.S.

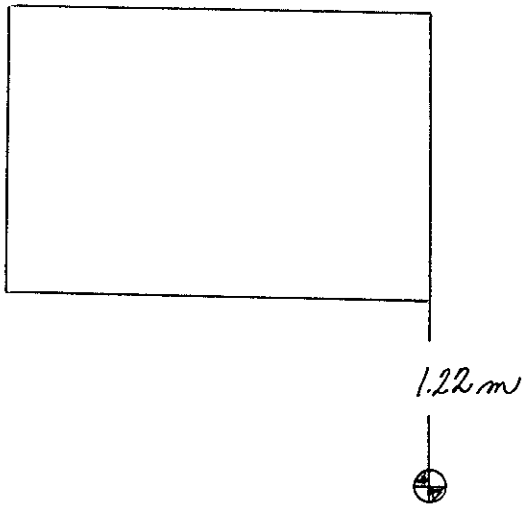

**City of Prince George
HISTORY SHEET**

008107000-
S

SHEET NUMBER

Roll Number

Legal: LOT'S PART OF P.L. 7 BLOCK D.L. 343 PLAN 1268

Address:

Sanitary Connection: # SIZE MATERIAL INV. CONNECTED

Water Connection # 9846 SIZE 150 mm MATERIAL A.C. METER CONNECTED YES

Storm Connection: # SIZE MATERIAL INV. CONNECTED

Cash Receipt No's: WATER SANITARY STORM

CURB FROM PROPERTY LINE PAVEMENT WIDTH

B.C. HYDRO UNDERGROUND CONNECTION


B.C. TELEPHONE UNDERGROUND CONNECTION

INLAND GAS

Information Sheets:

Comments: LAKELAND MILLS - LOCATION TAKEN FROM P.G. PRECUT BLDG.
FOR MORE INFORMATION SEE ENG DWG. 3050

SITE PLAN N.T.S.

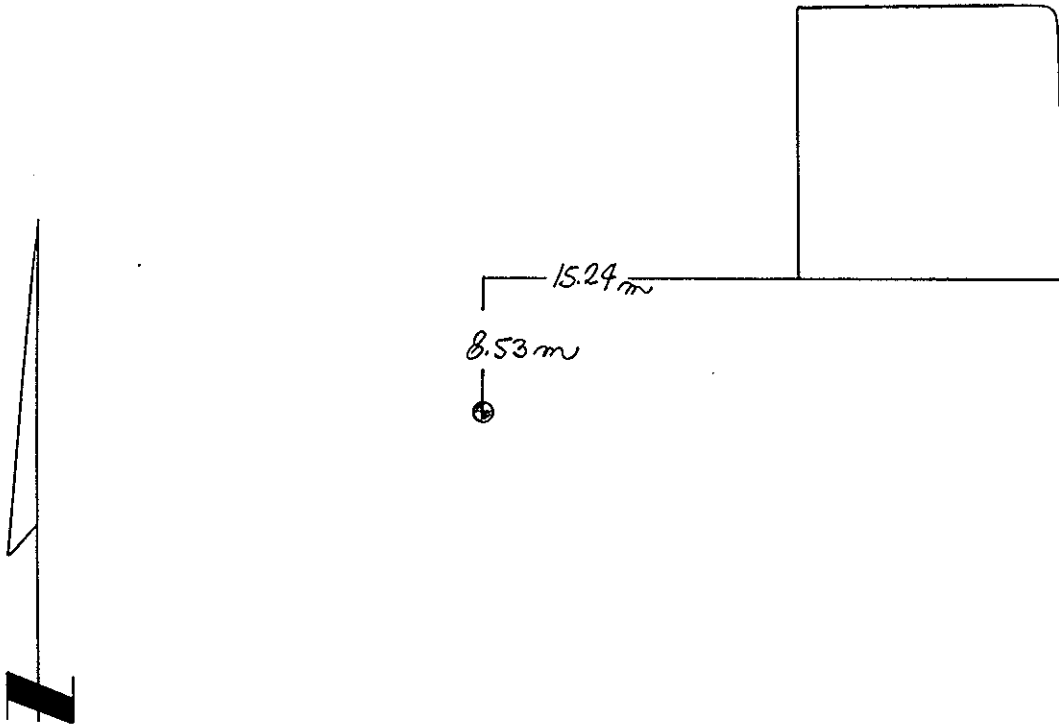

**City of Prince George
HISTORY SHEET**

005107006-
5

SHEET NUMBER

Roll Number

Legal: LOT'S *PCL 2* BLOCK *2* D.L. *343* PLAN *1268*

Address: *700 1st. AVE.*

Sanitary Connection: # SIZE MATERIAL INV. CONNECTED

Water Connection # *7222* SIZE *40mm* MATERIAL *Copper* METER CONNECTED *YES*

Storm Connection: # SIZE MATERIAL INV. CONNECTED

Cash Receipt No's: WATER *457* SANITARY STORM

CURB FROM PROPERTY LINE PAVEMENT WIDTH

B.C. HYDRO UNDERGROUND CONNECTION


B.C. TELEPHONE UNDERGROUND CONNECTION

INLAND GAS

Information Sheets:

Comments: *FOR MORE INFORMATION SEE ENV. DUG. 3650*

SITE PLAN N.T.S.

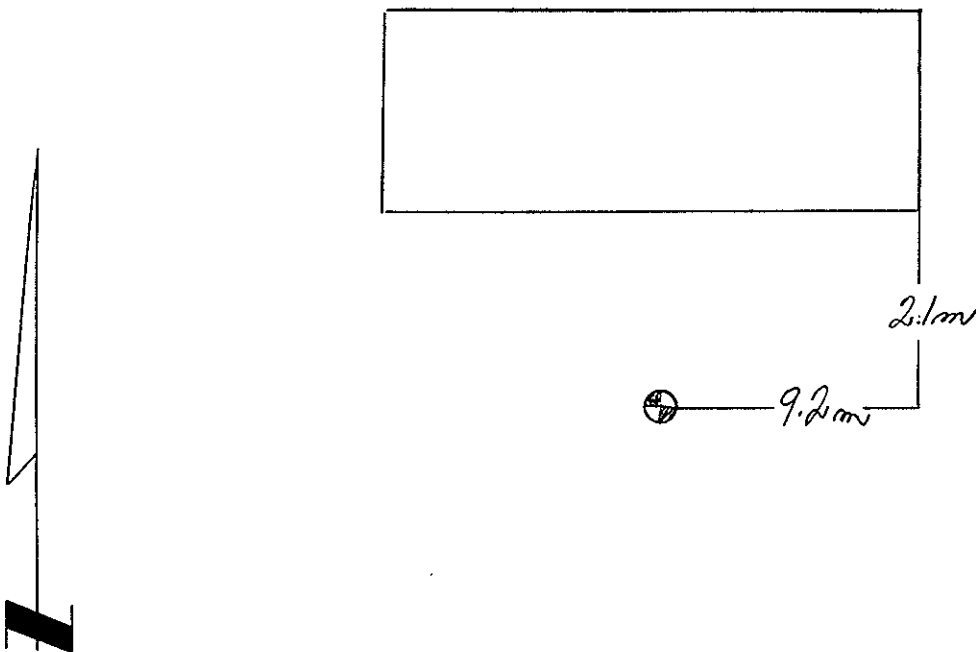

**City of Prince George
HISTORY SHEET**

005107008-5
5

SHEET NUMBER

Roll Number

Legal: LOT'S *PL 7* BLOCK D.L. *343* PLAN *1268*

Address: *760 1st AVE*

Sanitary Connection: # SIZE MATERIAL INV. CONNECTED

Water Connection # *4266* SIZE *20 mm* MATERIAL *Copper* METER CONNECTED
4265 SIZE *20 mm* MATERIAL *Copper*

Storm Connection: # SIZE MATERIAL INV. CONNECTED

Cash Receipt No's: WATER *2769* SANITARY STORM

CURB FROM PROPERTY LINE PAVEMENT WIDTH

B.C. HYDRO UNDERGROUND CONNECTION


B.C. TELEPHONE UNDERGROUND CONNECTION

INLAND GAS

Information Sheets:

Comments: *FOR MORE INFORMATION SEE ENG. DUB. 3650*

SITE PLAN N.T.S.

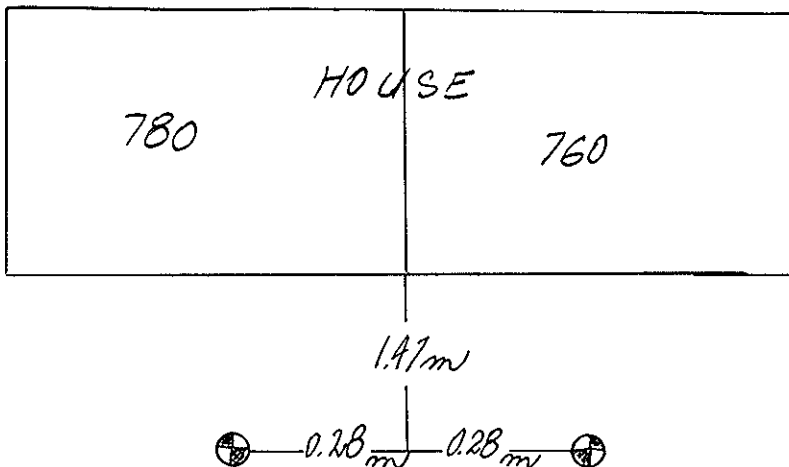

**City of Prince George
HISTORY SHEET**

00510-1008-6
S

SHEET NUMBER

Roll Number

Legal: LOT'S *REL 71* BLOCK D.L. *343* PLAN *1268*

Address: *1ST. AVE. CNR REPEATER STATION*

Sanitary Connection: # *98* *98* *200mm* SIZE MATERIAL INV. CONNECTED

Water Connection # *1692* SIZE MATERIAL METER CONNECTED

Storm Connection: # SIZE MATERIAL INV. CONNECTED

Cash Receipt No's: WATER SANITARY *631* STORM

CURB FROM PROPERTY LINE PAVEMENT WIDTH

B.C. HYDRO UNDERGROUND CONNECTION


B.C. TELEPHONE UNDERGROUND CONNECTION

INLAND GAS

Information Sheets:

Comments: *FOR MORE INFORMATION SEE ENCL. DWG 3650*

SITE PLAN N.T.S.

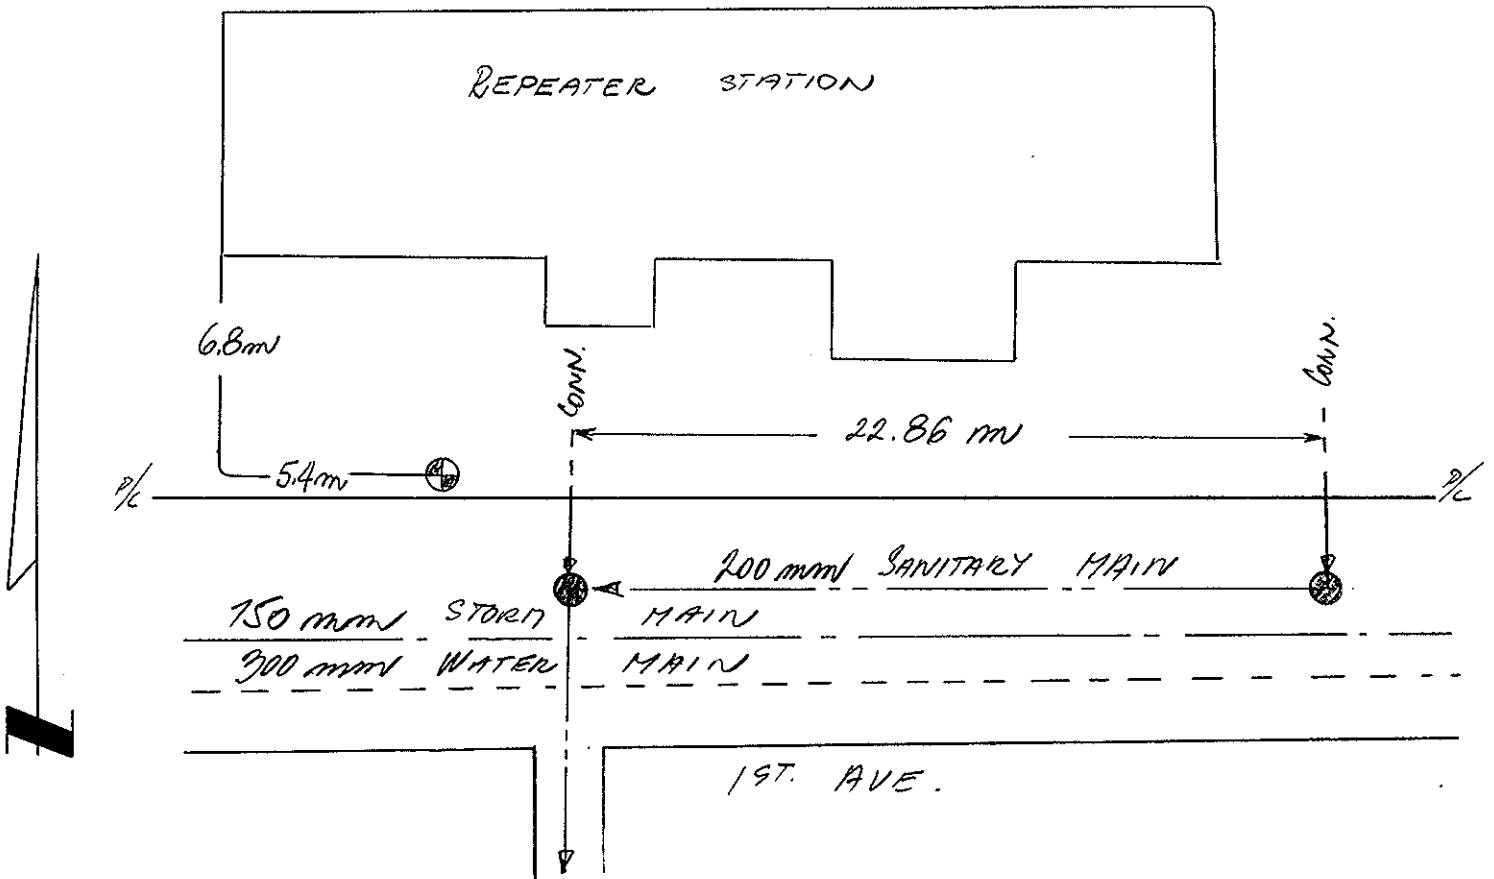

**City of Prince George
HISTORY SHEET**

005104000-1
S

SHEET NUMBER

Roll Number

Legal: LOT'S *P.L. 2* BLOCK D.L. *343* PLAN *1268*

Address: *1100 1ST. AVE.*

Sanitary Connection: # *11249* SIZE *150mm* MATERIAL *AC* INV. CONNECTED

Water Connection # SIZE *100mm* MATERIAL *I.C.* METER CONNECTED

Storm Connection: # SIZE MATERIAL INV. CONNECTED

Cash Receipt No's: WATER SANITARY *0918* STORM

CURB FROM PROPERTY LINE PAVEMENT WIDTH

B.C. HYDRO UNDERGROUND CONNECTION


B.C. TELEPHONE UNDERGROUND CONNECTION

INLAND GAS

Information Sheets:

Comments: *FOR MORE INFORMATION SEE ENG. DWG. 3650*

SITE PLAN N.T.S.

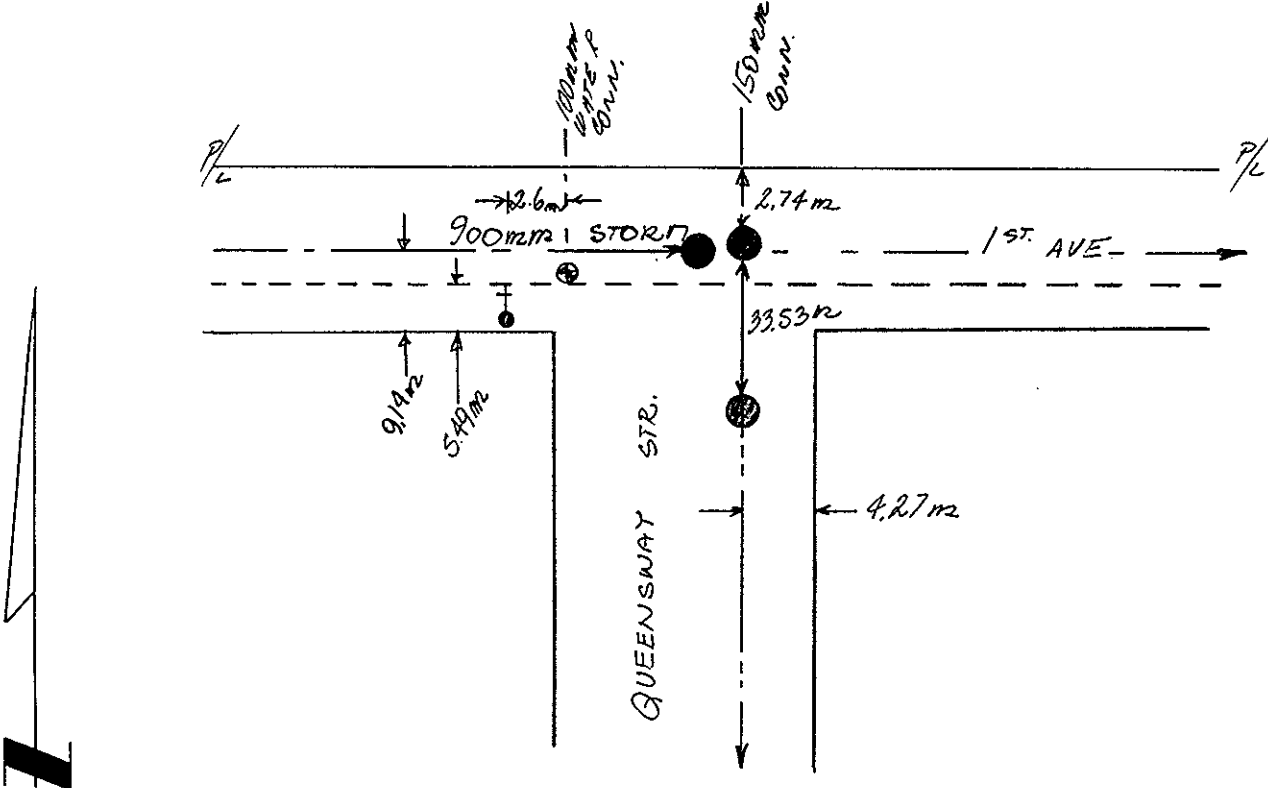

**City of Prince George
HISTORY SHEET**

00510-1006-6
S

SHEET NUMBER

Roll Number

Legal: LOT'S LEASE 2780 BLOCK 2 D.L. 343 PLAN 1268

Address: (PRINCE GEORGE PRECUT) (NORTHERN CANTONS)

Sanitary Connection: # SIZE MATERIAL INV. CONNECTED

Water Connection # 9142 SIZE 25mm MATERIAL Copper METER CONNECTED

Storm Connection: # SIZE MATERIAL INV. CONNECTED

Cash Receipt No's: WATER 581 SANITARY STORM

CURB FROM PROPERTY LINE PAVEMENT WIDTH

B.C. HYDRO UNDERGROUND CONNECTION


B.C. TELEPHONE UNDERGROUND CONNECTION

INLAND GAS

Information Sheets:

Comments: FOR MORE INFORMATION SEE ENG. DWG 3650

SITE PLAN N.T.S.

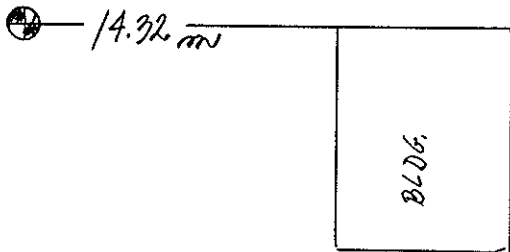

City of Prince George
HISTORY SHEET

002101008-9
5

SHEET NUMBER **2950** Roll Number

Legal: LOT'S **2** BLOCK D.L. **343** PLAN **1268**

Address: **RIVER RD. - D & M SERVICES.**

Sanitary Connection: # SIZE MATERIAL INV. CONNECTED

Water Connection # **12149** SIZE **1"** MATERIAL **log** METER CONNECTED

Storm Connection: # SIZE MATERIAL INV. CONNECTED

Cash Receipt No's: WATER **1450** SANITARY STORM

CURB FROM PROPERTY LINE PAVEMENT WIDTH

B.C. HYDRO UNDERGROUND CONNECTION


B.C. TELEPHONE UNDERGROUND CONNECTION

INLAND GAS

Information Sheets:

Comments:

SITE PLAN N.T.S.

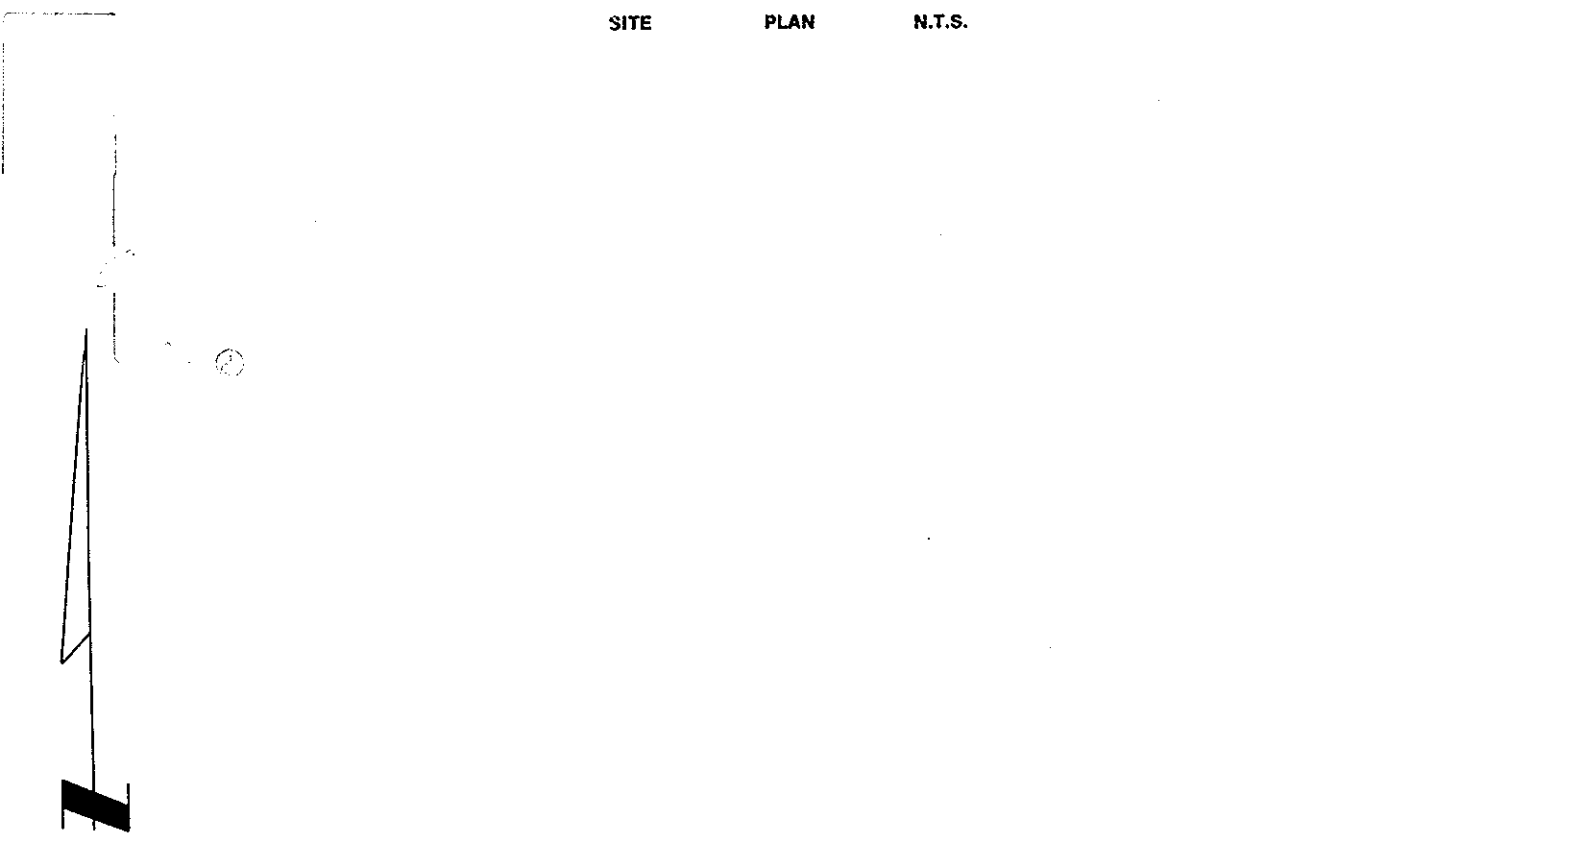

**City of Prince George
HISTORY SHEET**

008107008-10
5

SHEET NUMBER

Roll Number

Legal: LOT'S PARCEL 2 BLOCK _____ D.L. 343 PLAN 1268

Address: CANADIAN NATIONAL BANK

Sanitary Connection: # _____ SIZE _____ MATERIAL _____ INV. _____ CONNECTED _____

Water Connection # 4985 SIZE 150 mm MATERIAL STEEL INV. _____ CONNECTED _____
 # 12461 SIZE 38 mm MATERIAL 2U, STEEL METER _____ CONNECTED _____
 # 12488 SIZE 300 mm MATERIAL _____ INV. _____ CONNECTED _____

Storm Connection: # _____ SIZE _____ MATERIAL _____ INV. _____ CONNECTED _____

Cash Receipt No's: WATER 2184 ¹²⁸⁸⁸ 3014 SANITARY _____ STORM _____

CURB FROM PROPERTY LINE _____ PAVEMENT WIDTH _____


B.C. HYDRO O/H UNDERGROUND CONNECTION _____

B.C. TELEPHONE O/H UNDERGROUND CONNECTION _____

INLAND GAS AS SHOWN.

Information Sheets: _____

Comments: 38 mm CONN. WITH THAW WIRE.

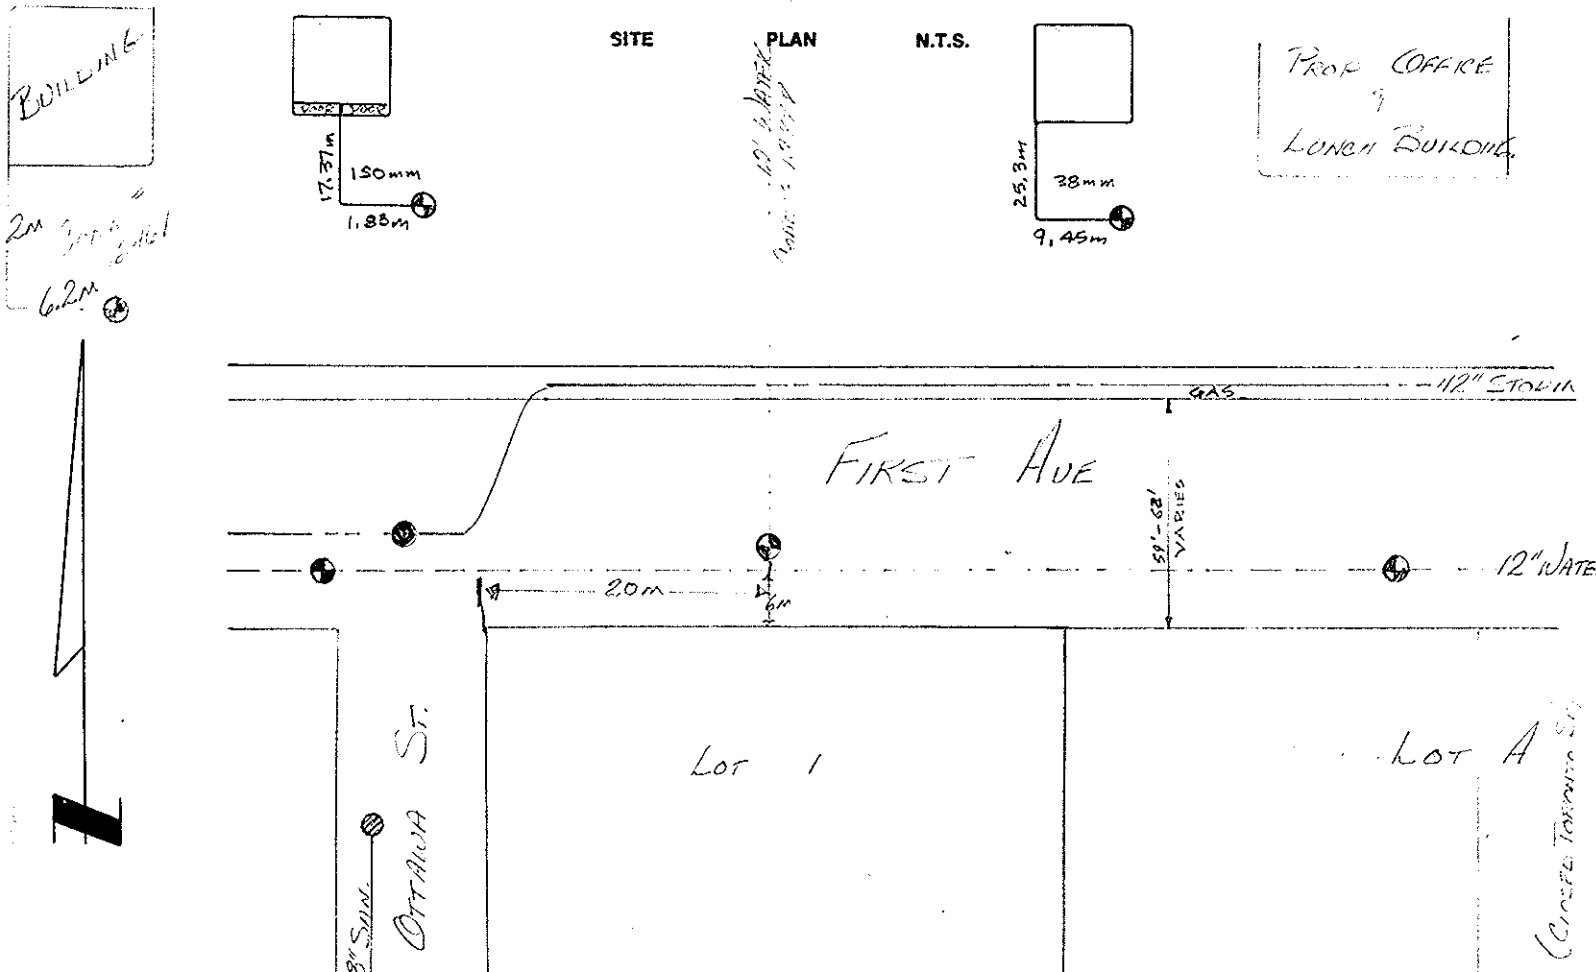

**City of Prince George
HISTORY SHEET**

005107008-11
S

SHEET NUMBER

Roll Number

Legal: LOT'S 70L 2 BLOCK _____ D.L. 343 PLAN 1268

Address: RIVER RD. (RIVER BANK TRUCK SERVICE.)

Sanitary Connection: # _____ SIZE _____ MATERIAL _____ INV. _____ CONNECTED _____

Water Connection # _____ SIZE _____ MATERIAL _____ METER _____ CONNECTED _____

Storm Connection: # _____ SIZE _____ MATERIAL _____ INV. _____ CONNECTED _____

Cash Receipt No's: WATER _____ SANITARY _____ STORM _____

CURB FROM PROPERTY LINE _____ PAVEMENT WIDTH _____

B.C. HYDRO _____ UNDERGROUND CONNECTION _____

B.C. TELEPHONE _____ UNDERGROUND CONNECTION _____

INLAND GAS _____

Information Sheets:

Comments: FOR MORE INFORMATION SEE ENR. DUB. 3650.

SITE PLAN N.T.S.

